


T. 17S, R. 20 E, W.M.

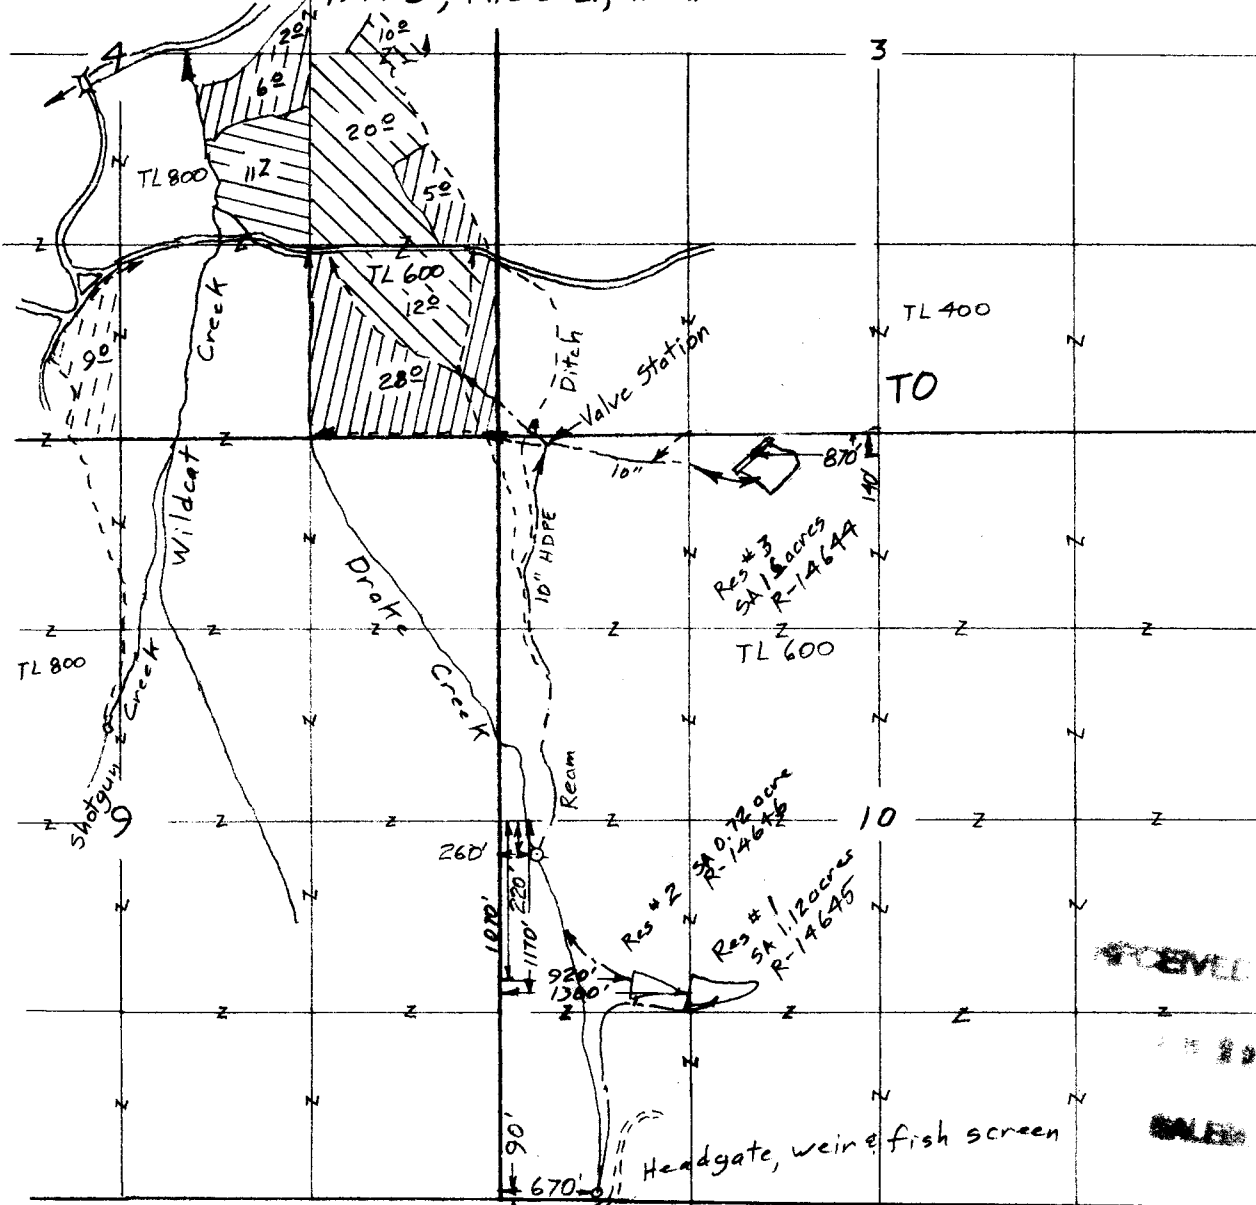

Scale
1" = 1320'
(4" = 1 mile)

Surveyed July 10, 2012


Claim of Beneficial Use Map
for
Shotgun Ranch, LLC

3 reservoirs also used as
bulge in system for:

- ⊗ C-649 42[±] acres
- ⊗ C-81673 11[±] acres
- ⊗ C-10844 41[±] acres

- #1 App. R-87072 Per. R-14645
- #2 App. R-87073 Per. R-14646
- #3 App. R-87071 Per. R-14644

This map is for the purpose of
locating a water right only
and has no intent to provide
legal dimensions or the location
of property lines.

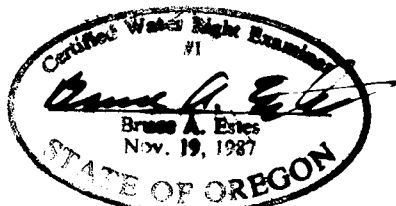

Renewal Dec 31, 2013

ESTES SURVEYS, LLC
 PO Box 47640
 Salem, OR 97306-7919
 (503) 584-7500
 80382 Arnold Rd
 Bend, OR 97702
 (541) 382-7391