


T. 17S., R. 20E., W.M.

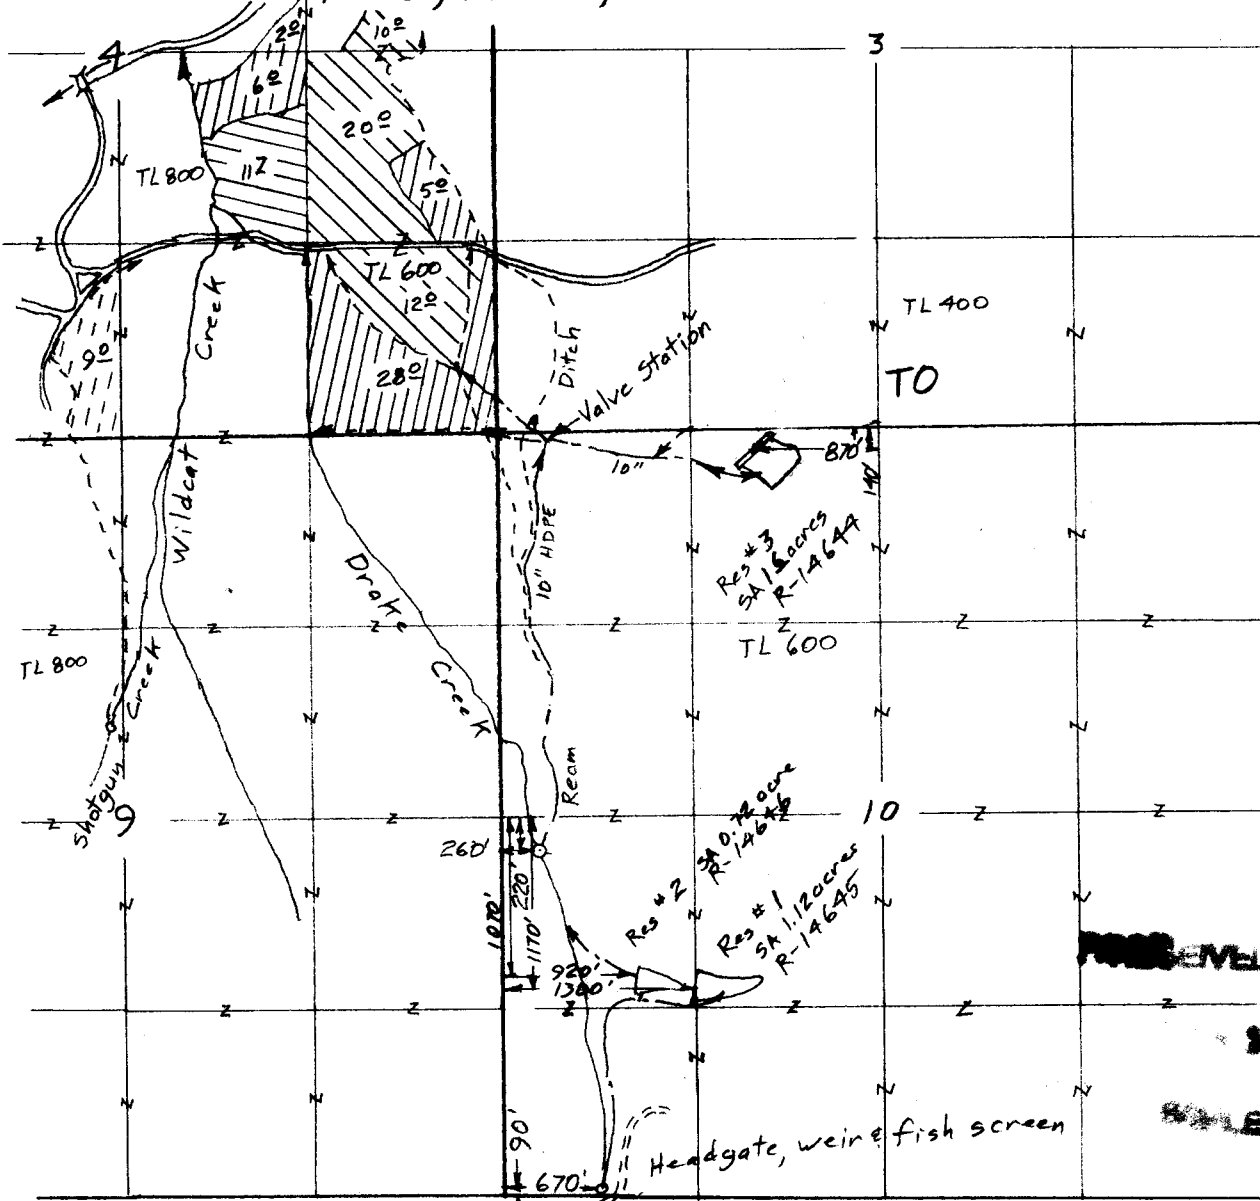

Scale
1" = 1320'
(4" = 1 mile)

Surveyed July 10, 2012


Claim of Beneficial Use Map
for
Shotgun Ranch, LLC

3 reservoirs also used as bulge in system for:

- ⊗ C-649 42^o acres
- ⊗ C-81673 112^o acres
- ⊗ C-10844 41^o acres

- *1 App. R-87072 Per. R-14645
- *2 App. R-87073 Per. R-14646
- *3 App. R-87071 Per. R-14644

This map is for the purpose of locating a water right only and has no intent to provide legal dimensions or the location of property lines.

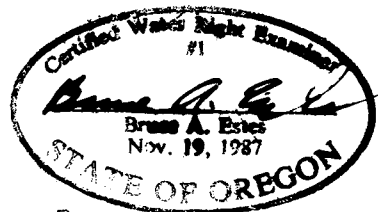

ESTES SURVEYS, LLC
 PO Box 17640
 Salem, OR 97388-7610
 (503) 508-7600
 60382 Arnold Rd
 Bend, OR 97702
 (541) 382-7391