


Map

accompanying Final Proof of Permit No. 9526 by Eugene L. & Sarah Ann Hopkins to waters of Anderson Creek tributary to Bear Creek Jackson County Oregon For the purpose of Irrigation

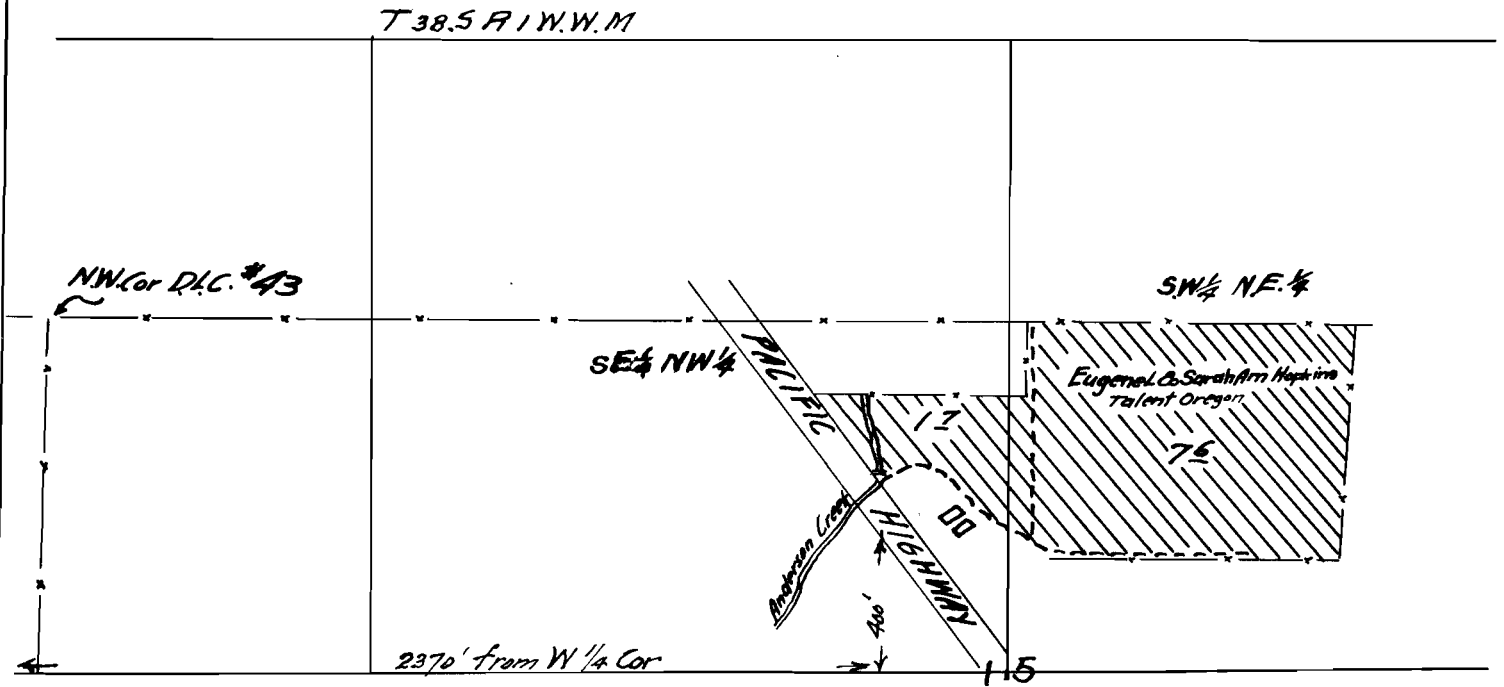

Map made from plane table survey by Chester A. Cummings

13261