


FINAL PROOF MAP

TO TRANSFER RIGHTS AND
CHANGE POINT OF APPROPRIATION
FOR T-11037
TIM WARKENTIN

TOWNSHIP 25 SOUTH, RANGE 18 EAST, SECTION 9, W.M.
TAX LOTS: 2100 AND 2300

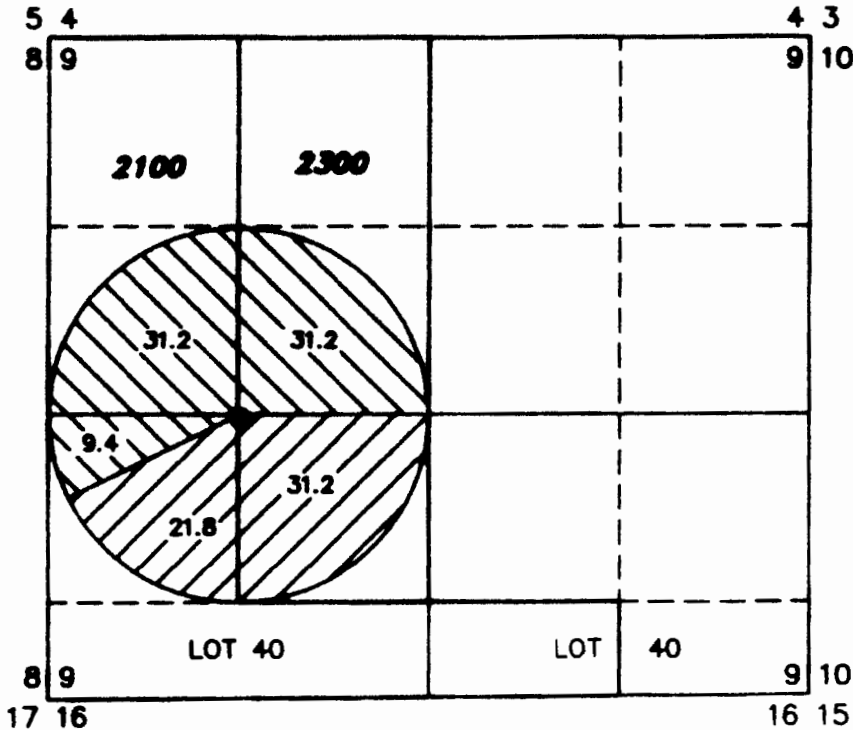

RECEIVED

APR 17 2012

WATER RESOURCES DEPT
SALEM, OREGON

- 53.0 ACRES WATER RIGHTS FROM CERTIFICATE #00220 (C-10326), AS SHOWN.
- 71.8 ACRES WATER RIGHTS FROM CERTIFICATE #00221 (C-0074), AS SHOWN.



RENEWAL DATE: 12/31/2012

- **LAKE 51272**
NEW WELL LOCATED IN THE NE 1/4 SW 1/4 SECTION 9,
T25S R18E, W.M. AND 20 FEET SOUTH AND 1300 FEET
EAST FROM THE WEST 1/4 CORNER OF SECTION 9.

NEWLY INSTALLED METER IS APPROXIMATELY 11.0
FEET EAST ALONG DELIVERY PIPE FROM WELL.

THIS MAP IS FOR THE PURPOSE OF LOCATING A WATER
RIGHT ONLY AND HAS NO INTENT TO PROVIDE LEGAL
DIMENSIONS OR THE LOCATION OF PROPERTY LINES

<p>PREPARED FOR:</p> <p>TIM WARKENTIN P.O. BOX 12 CHRISTMAS VALLEY, OR 97641</p>	<p>PREPARED BY:</p> <div style="display: flex; align-items: center;"> <div> <p>ALL POINTS ENGINEERING AND SURVEYING, INC. P.O. BOX 767 (CRR) TERREBONNE, OR 97760 (541) 548-5833 www.APEandS.com</p> </div> </div>
--	---