


SECTIONS 4, 9 & 10, TWP.1 N. RANGE 17 E. W.M.
 CITY OF WASCO
 SHERMAN COUNTY, OREGON

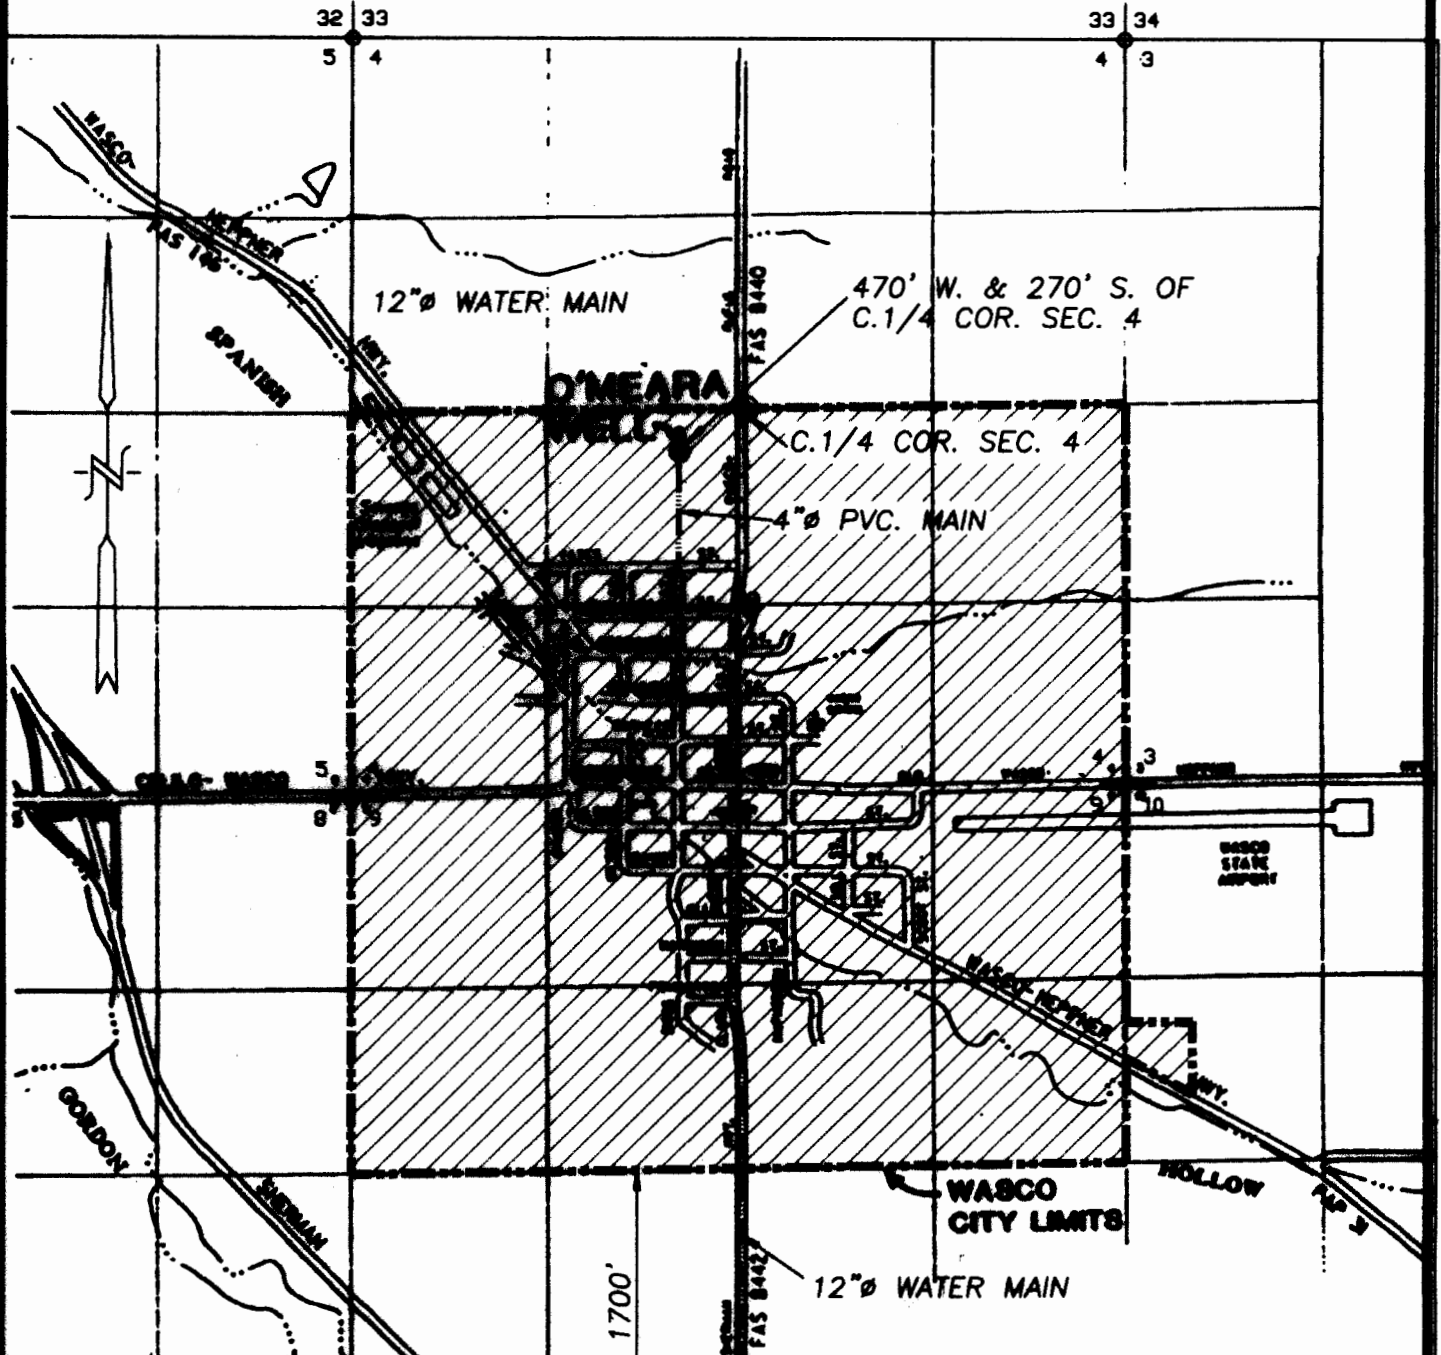

RECEIVED

OCT 03 2000

WATER RESOURCES DEPT.
 SALEM, OREGON

WATER RIGHT

TRANSFER FINAL PROOF SURVEY

SCALE: 1" = 1320'


CERTIFICATE No. 31377 & 34921

PERMIT No. T-6472

IN THE NAME OF:
CITY OF WASCO, OREGON

DATE: SEPTEMBER 20, 2000

BY: TENNESON ENGINEERING CORP.
 409 LINCOLN STREET,
 THE DALLES, OREGON. 97058
 PH. 541-296-9177
 FAX 541-296-6657

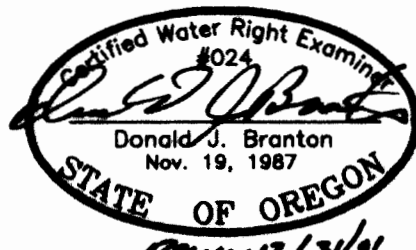

NOTE:

"THIS MAP IDENTIFIES THE LOCATION OF THE WATER RIGHT ONLY AND IS NOT INTENDED TO PROVIDE DIMENSIONS OR LOCATE PROPERTY OWNERSHIP LINES."

W.O. #8423 WTRT