


SECTIONS 4, 9 & 10, TWP.1 N. RANGE 17 E. W.M.  
 CITY OF WASCO  
 SHERMAN COUNTY, OREGON

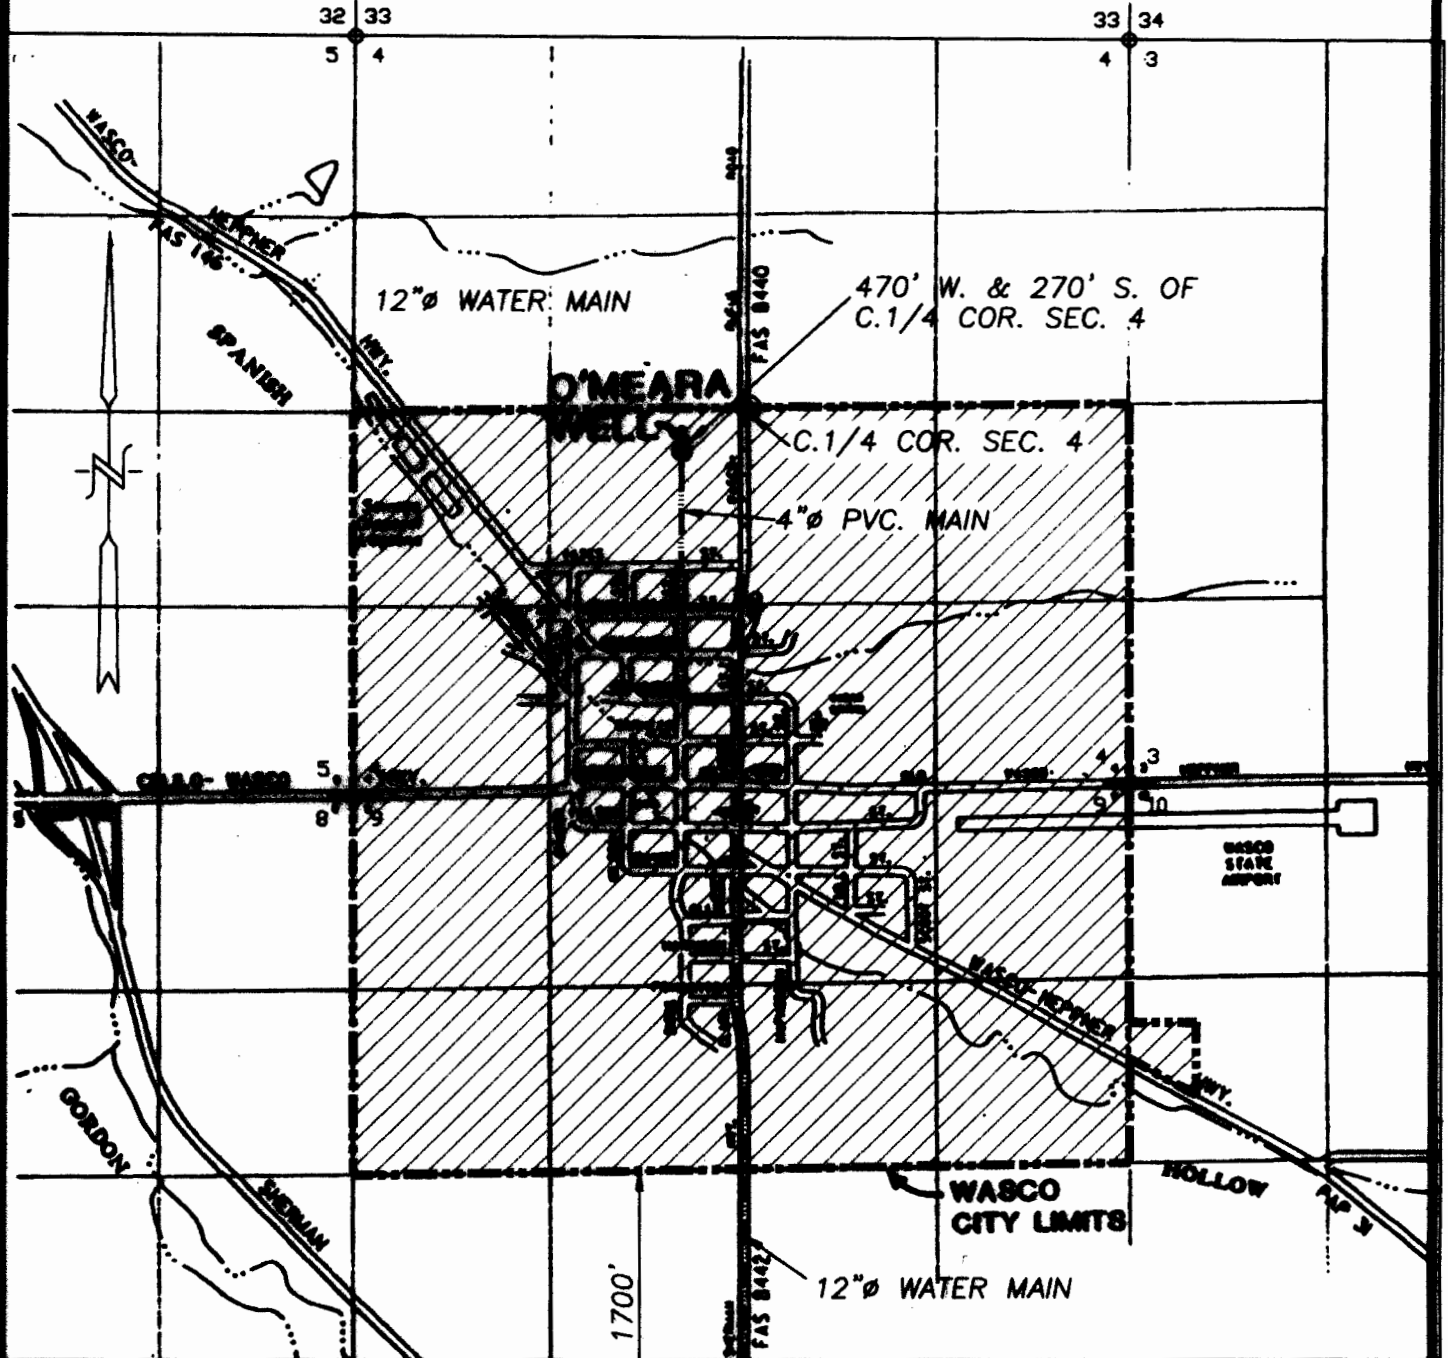

**RECEIVED**

OCT 03 2000

WATER RESOURCES DEPT.  
 SALEM, OREGON

**WATER RIGHT**

**TRANSFER FINAL PROOF SURVEY**

SCALE: 1" = 1320'

CERTIFICATE No. 31377 & 34921


PERMIT No. T-6472

IN THE NAME OF:

CITY OF WASCO, OREGON

DATE: SEPTEMBER 20, 2000

BY: TENNESON ENGINEERING CORP.  
 409 LINCOLN STREET,  
 THE DALLES, OREGON. 97058  
 PH. 541-296-9177  
 FAX 541-296-6657

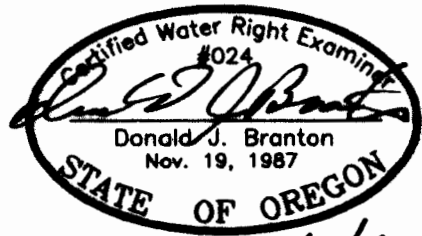

**NOTE:**

"THIS MAP IDENTIFIES THE LOCATION OF THE WATER RIGHT ONLY AND IS NOT INTENDED TO PROVIDE DIMENSIONS OR LOCATE PROPERTY OWNERSHIP LINES."

W.O. #8423 WTRT