



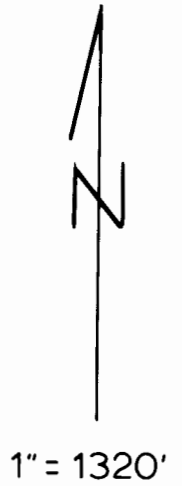


T.9S., R. 27 & 28 E., W.M.

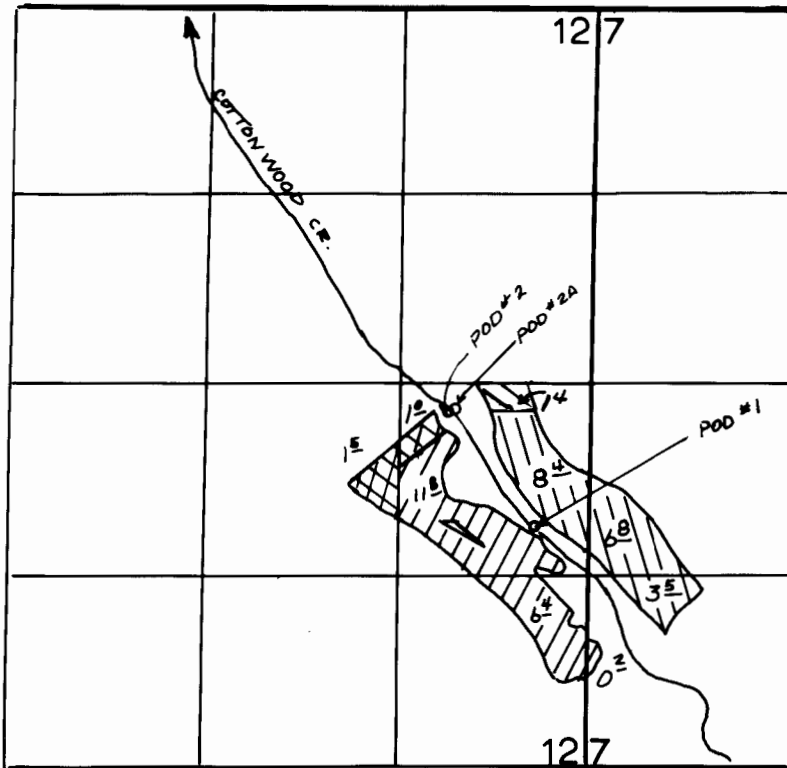


POD 1, 6120'S. & 2270'E. FROM THE CENTER 1/4 COR. SEC.1
 POD 2, 2450'N. & 1000' W. FROM THE S.E. CORNER OF SEC.12.
 POD 2A 2450'N. & 970' W. FROM THE S.E. CORNER OF SEC.12.

 POD 1 AND/OR 2A
 (prior cert. 44177)
 Add-Pod

 POD 1 & or 2
 (prior cert. 44179)
 Add-Pod

 POD 2A
 (prior cert. 44181)
 change in Pod

 POD 2
 (prior cert. 44181)
 change in Pod

FINAL PROOF SURVEY

UNDER

TRANSFER 5966

IN THE NAME OF

EARL RANDALL SWEET

SURVEYED 9/1/99, BY J. MILLER