


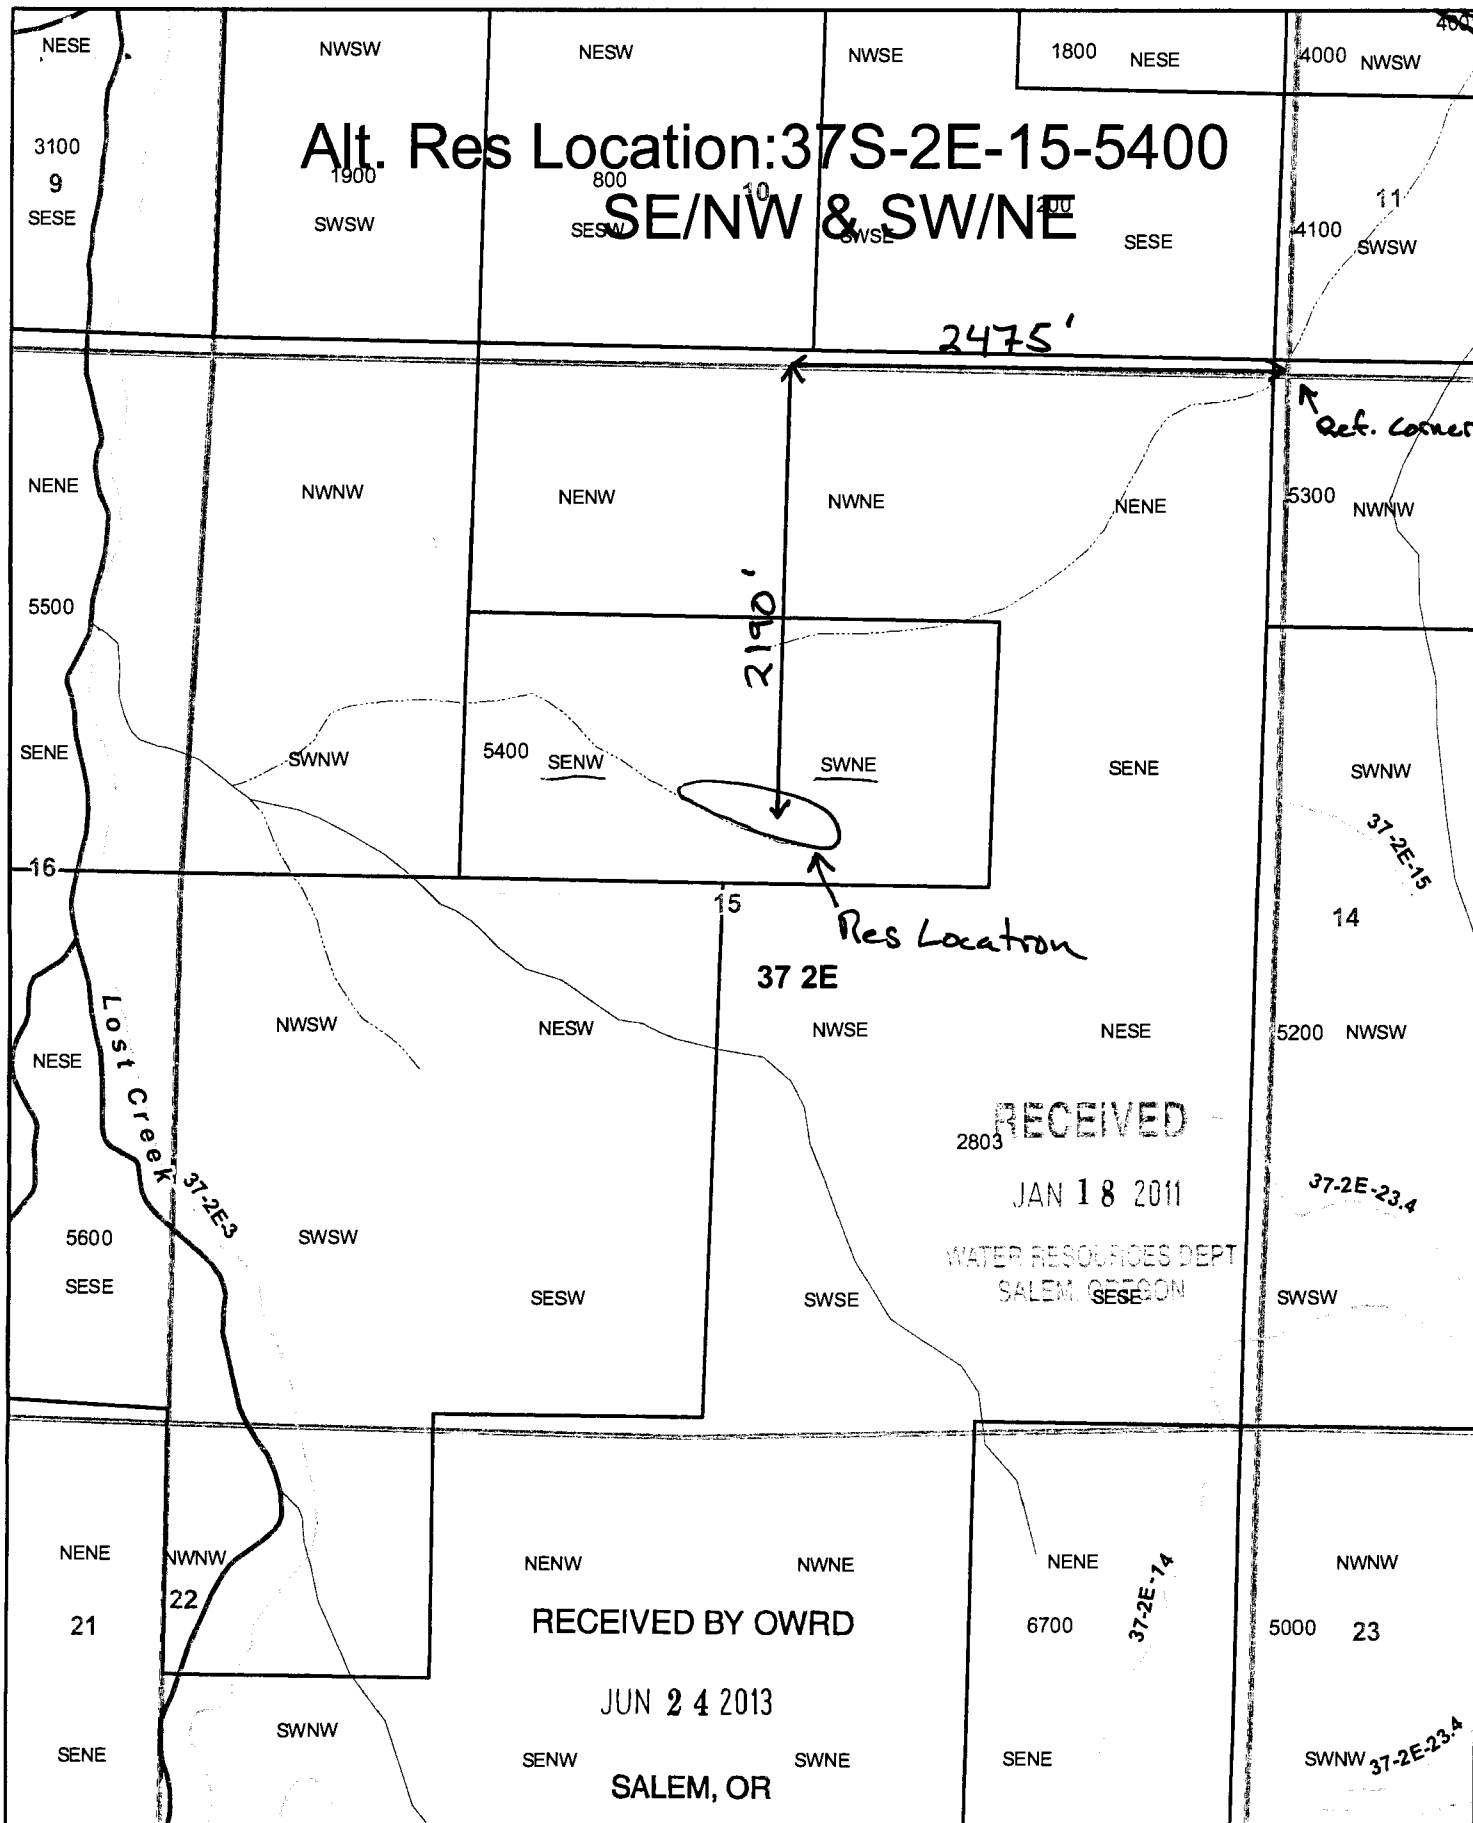

Legend

- Tax Lots
- quarter quarters
- Sections
- Townships

R-57682

1 inch = 952 feet

0 325 650 1,300 1,950 2,600 Feet