





















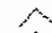

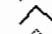
Polk County Map
 95 SW, SEC. 5
 9.5.5

-  Cntrl Map
-  cntrlr
-  cntrlmap
-  DLC
-  Railroad
-  Roads
-  GRAVEL
-  Section
-  Subdivision
-  Taxlot14
-  Taxlot Arrows14
-  Taxlot Boundary14
-  taxlot14
-  TaxMap
-  2
-  32
-  33
-  34
-  47
-  7
-  8
-  Updates

RECEIVED

JUN 24 2014

WATER RESOURCES DEPT
 SALEM, OREGON

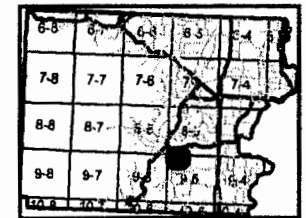

6/16/2014



1 in. = 400 ft.

N.E. CORNER
 SARAH A. BOWMAN
 DLC NO. 51

201
 224 AC

INT. CORNER
 DLC NO. 51

101 E.N.E. CORNER
 100 N
 10 AC

100
 44.75 AC

A# R-82055
 R# R-12234
 RES. LOCATED
 1640' N + 750' E.
 FROM NW CORNER
 JOHN H. SMITH
 DLC 50.

N.W. CORNER
 JOHN H. SMITH
 DLC NO. 50

105
 49.10 AC.

101
 67.30 AC.

601
 300
 47.79 AC.

101
 500
 52.73 AC

This map was produced using the Polk County GIS data. The GIS data is maintained by the county to support its governmental activities. The county is not responsible for map errors, omissions, misuse or misinterpretation.