

CROOK COUNTY


1"=2000'

SEE MAP 10 20

19 20

CROOK
19 20

THIS MAP WAS PREPARED FOR
ASSESSMENT PURPOSE ONLY.

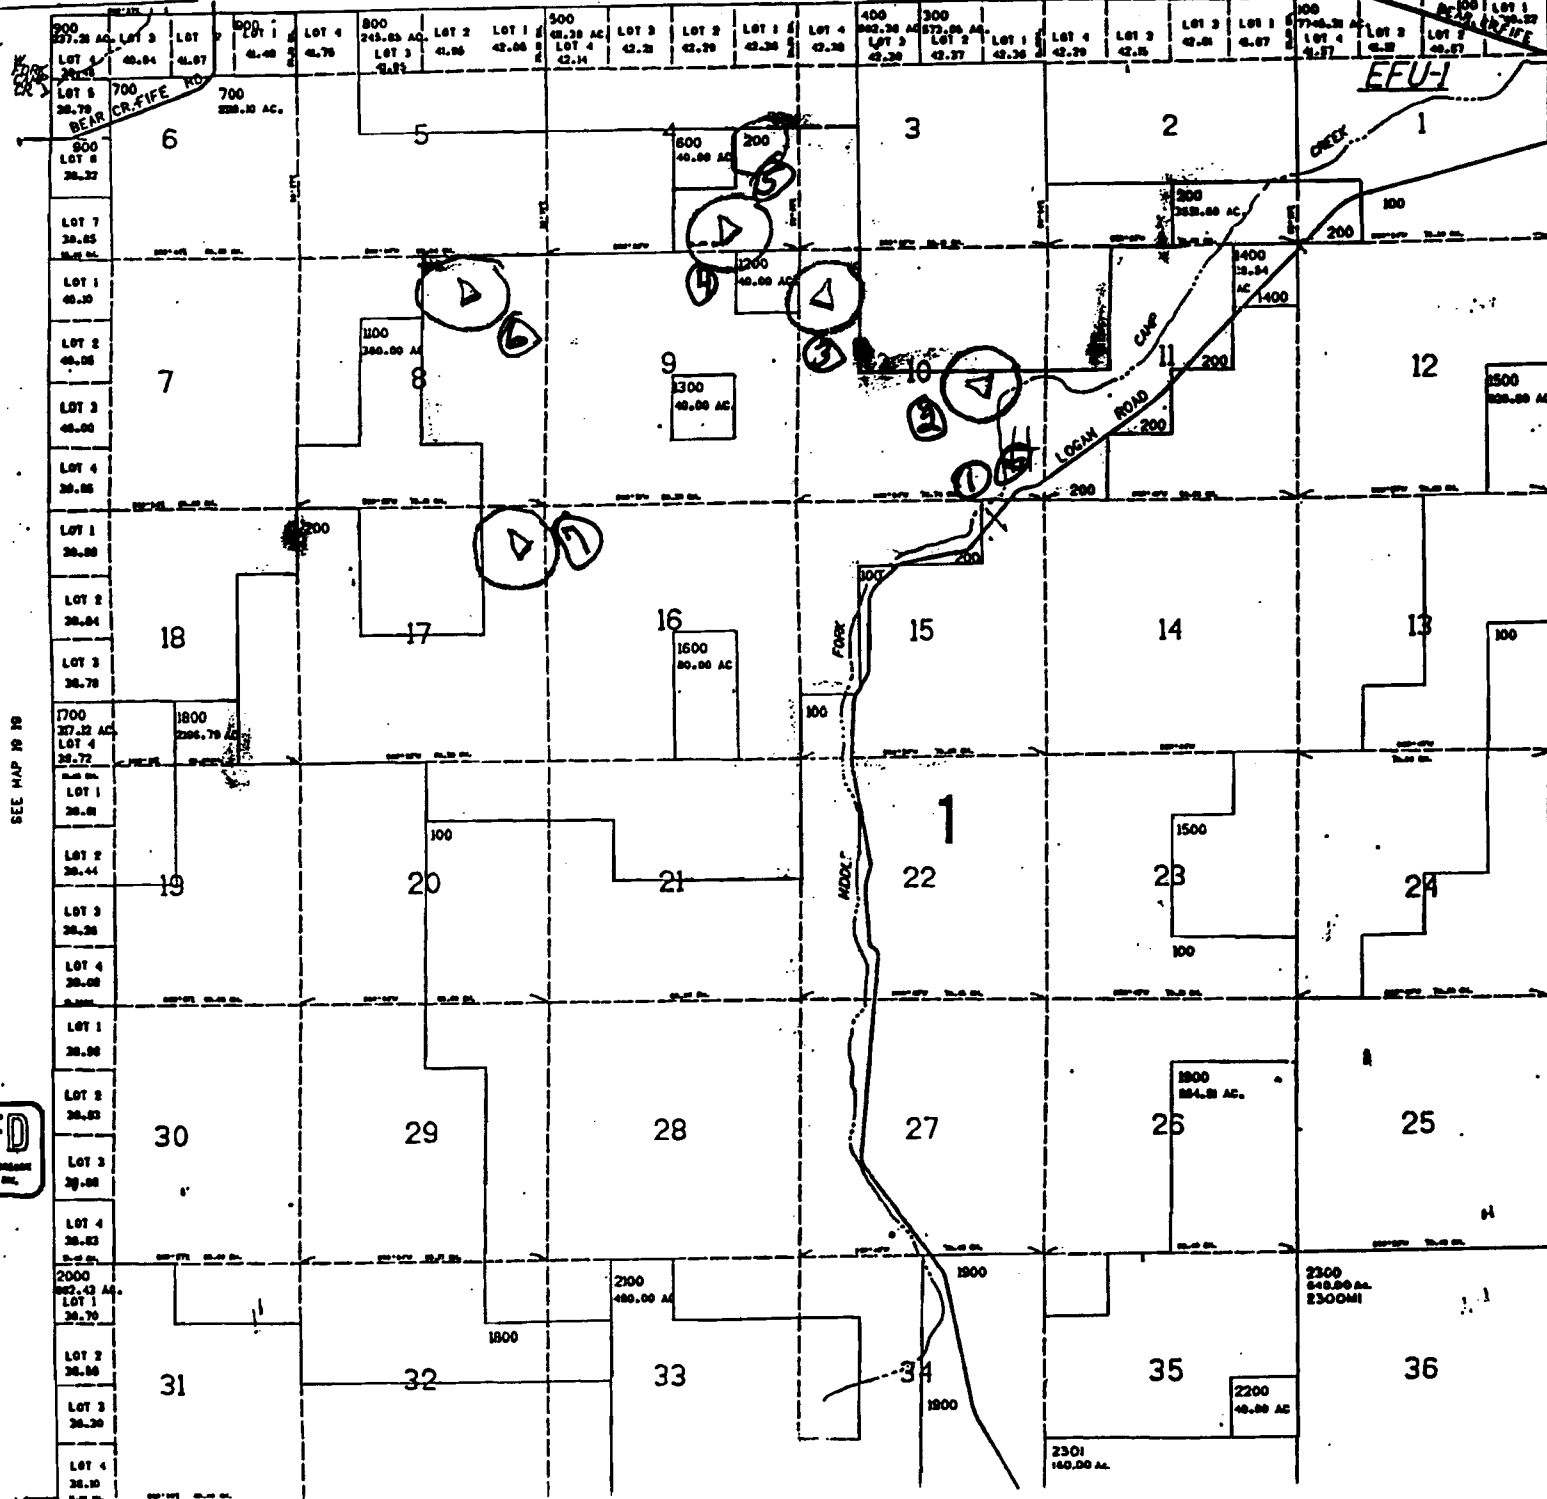

Permit No.

103610

112110

RECEIVED

AUG 11 1997

WATER RESOURCES DEPT
SALEM, OREGON

RECEIVED
MAR 3 1 1992

Over