






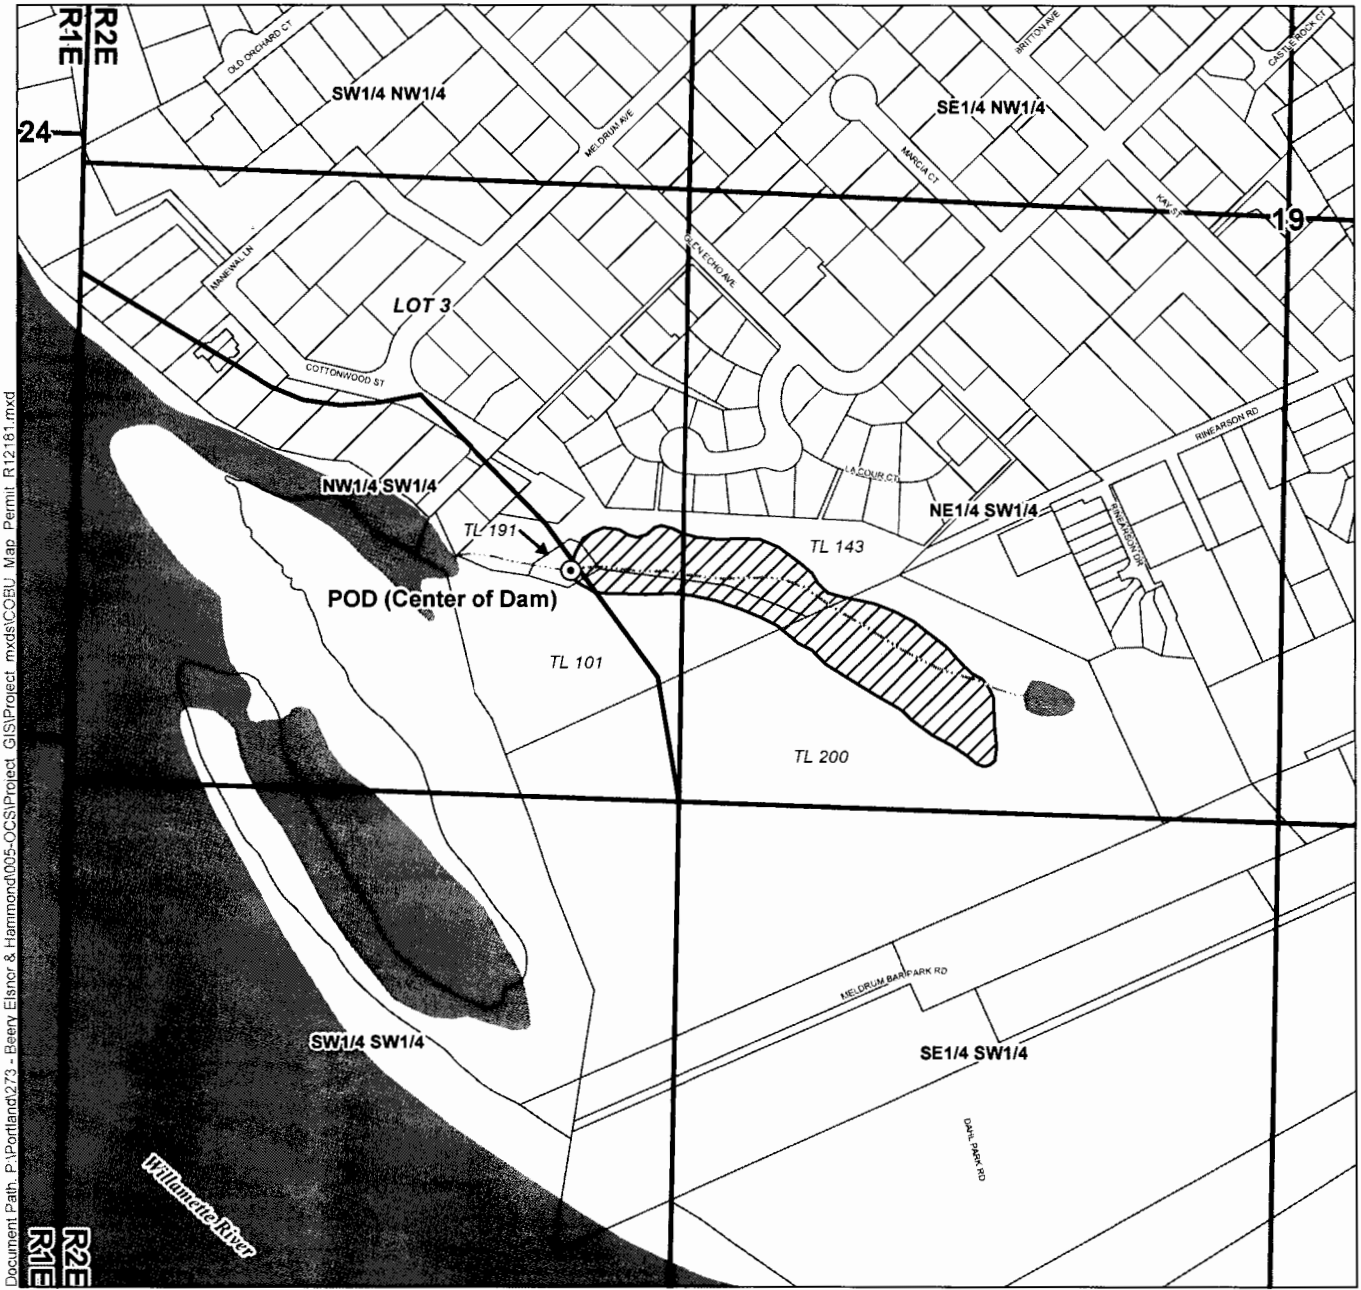

Claim of Beneficial Use Map Permit R-12181 (Application R-81772) Water Right in the Name of City of Gladstone

Section 19, Township 2 South, Range 2 East (W.M.)



Document Path: P:\Portland\273 - Beery Elsnor & Hammond\005-OC\GIS\Project mxd\COBU Map_Permit_R12181.mxd

LEGEND

-  Point of Diversion (POD)
-  Place of Use (POU)
-  Government Lots
-  Tax Lots
-  Waterbodies
-  Watercourses

POD LOCATION DESCRIPTION

POD (Center of Dam)
Located 845 feet South and 1,075 feet East from the West 1/4 corner of Section 19, Township 2 South, Range 2 East (W.M.)

RECEIVED
JUN 26 2014
CITY OF GLADSTONE

Disclaimer
This map was prepared for the purpose of identifying the location of a water right only and it is not intended to provide legal dimensions or location of property ownership lines.

Map Notes
Date: June 26, 2014
Data Sources: OWRD, METRO RLIS
Prepared By: GSI Water Solutions, Inc.

