


SCALE 1:48000

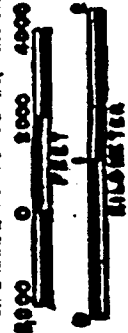

RECEIVED
MAR 3 1 1992
47% OF AVERAGE STATE OF OREGON
45% STATE OF A APPROVED, INC.

DUCK

THIS MAP WAS PREPARED FOR
ASSESSMENT PURPOSE ONLY.

CROOK COUNTY


1:2000'

SEE MAP 18 20

19 20

CROOK
19 20

EFU-1

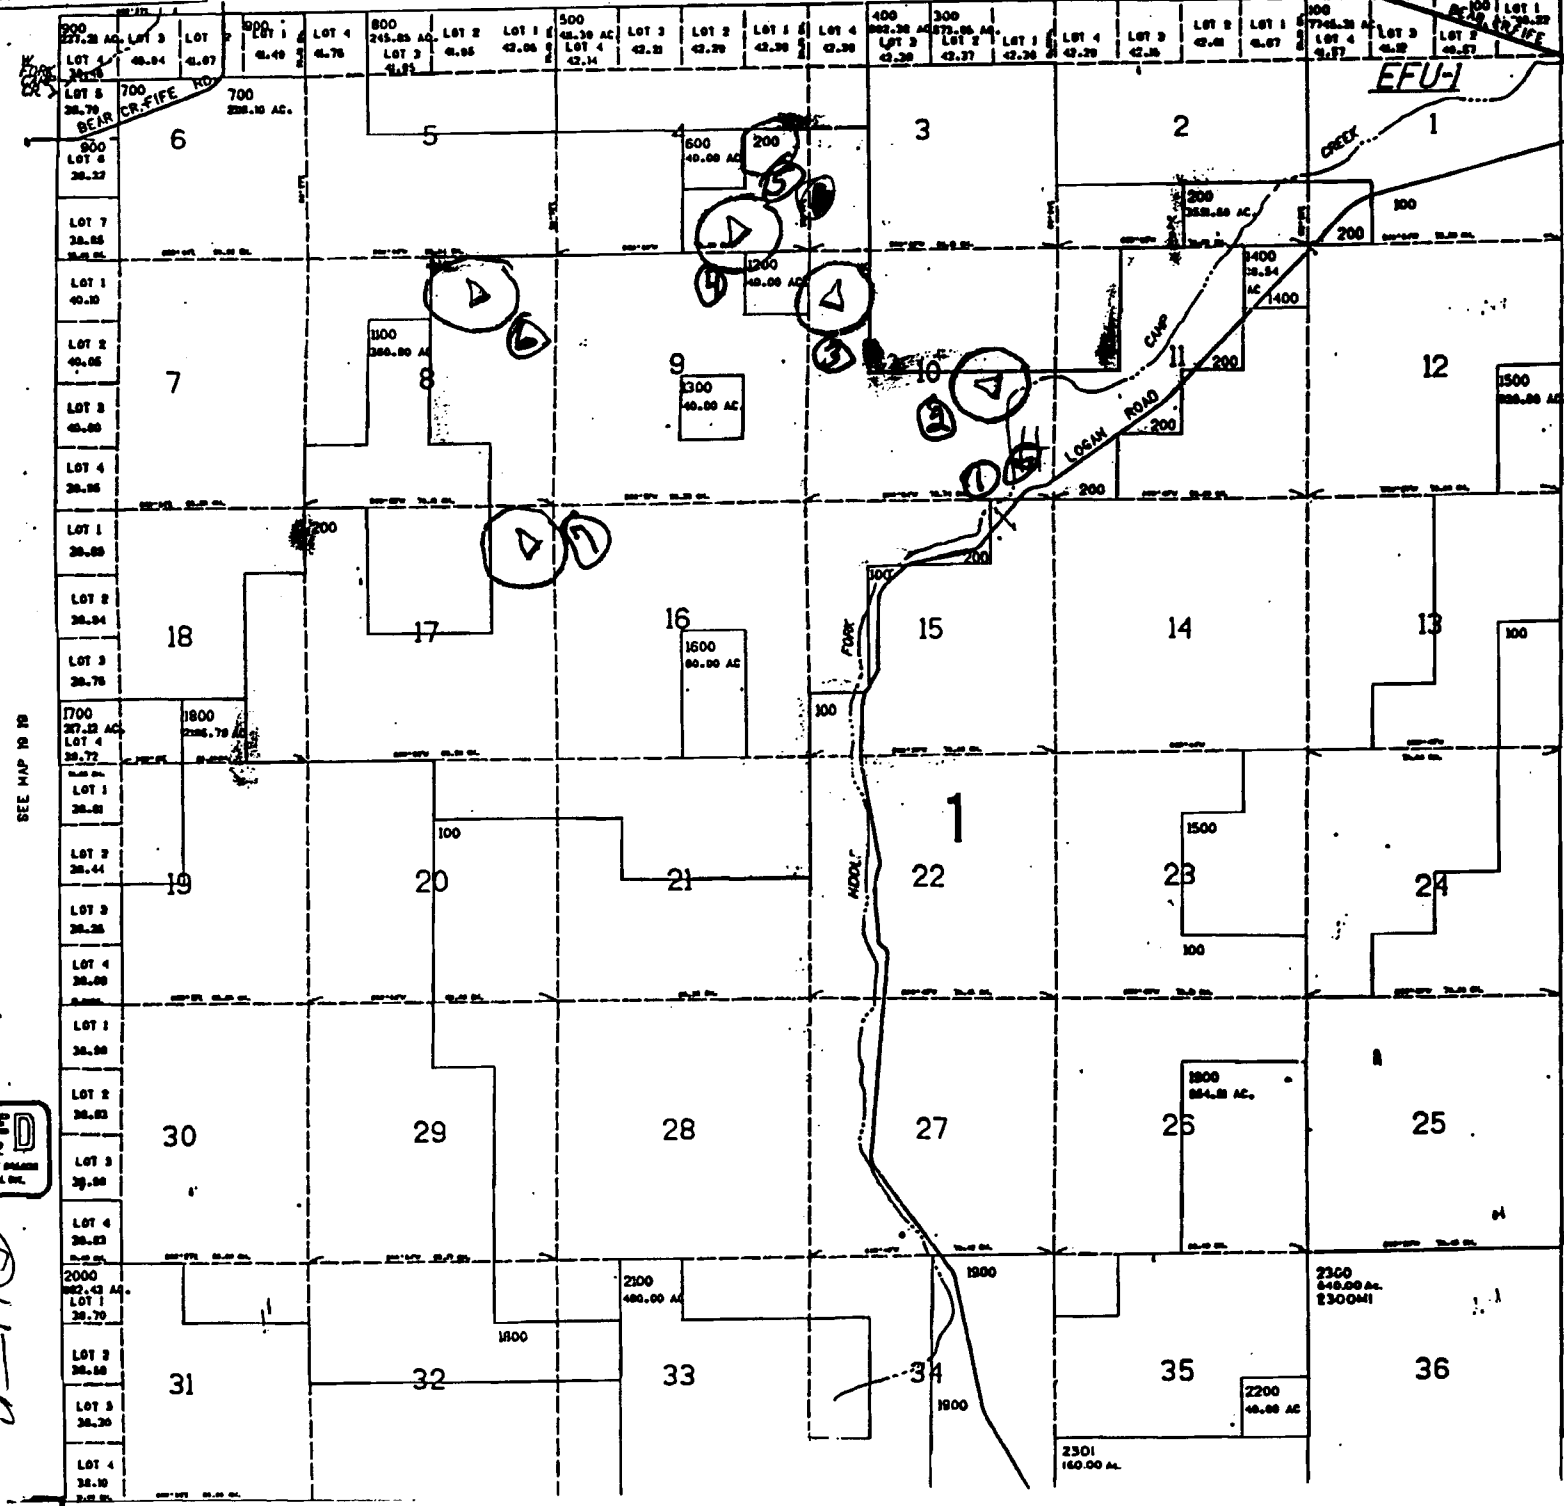

SEE MAP 18 21

Permit No. 112171

WATER RESOURCES DEPT
SALEM, OREGON

Permit No. 283527

1283611

AUG 11 1997

RECEIVED