

CROOK COUNTY


1"=2000'

SEE MAP 18 20

19 20

CROOK
19 20

THIS MAP WAS PREPARED FOR
ASSESSMENT PURPOSE ONLY.

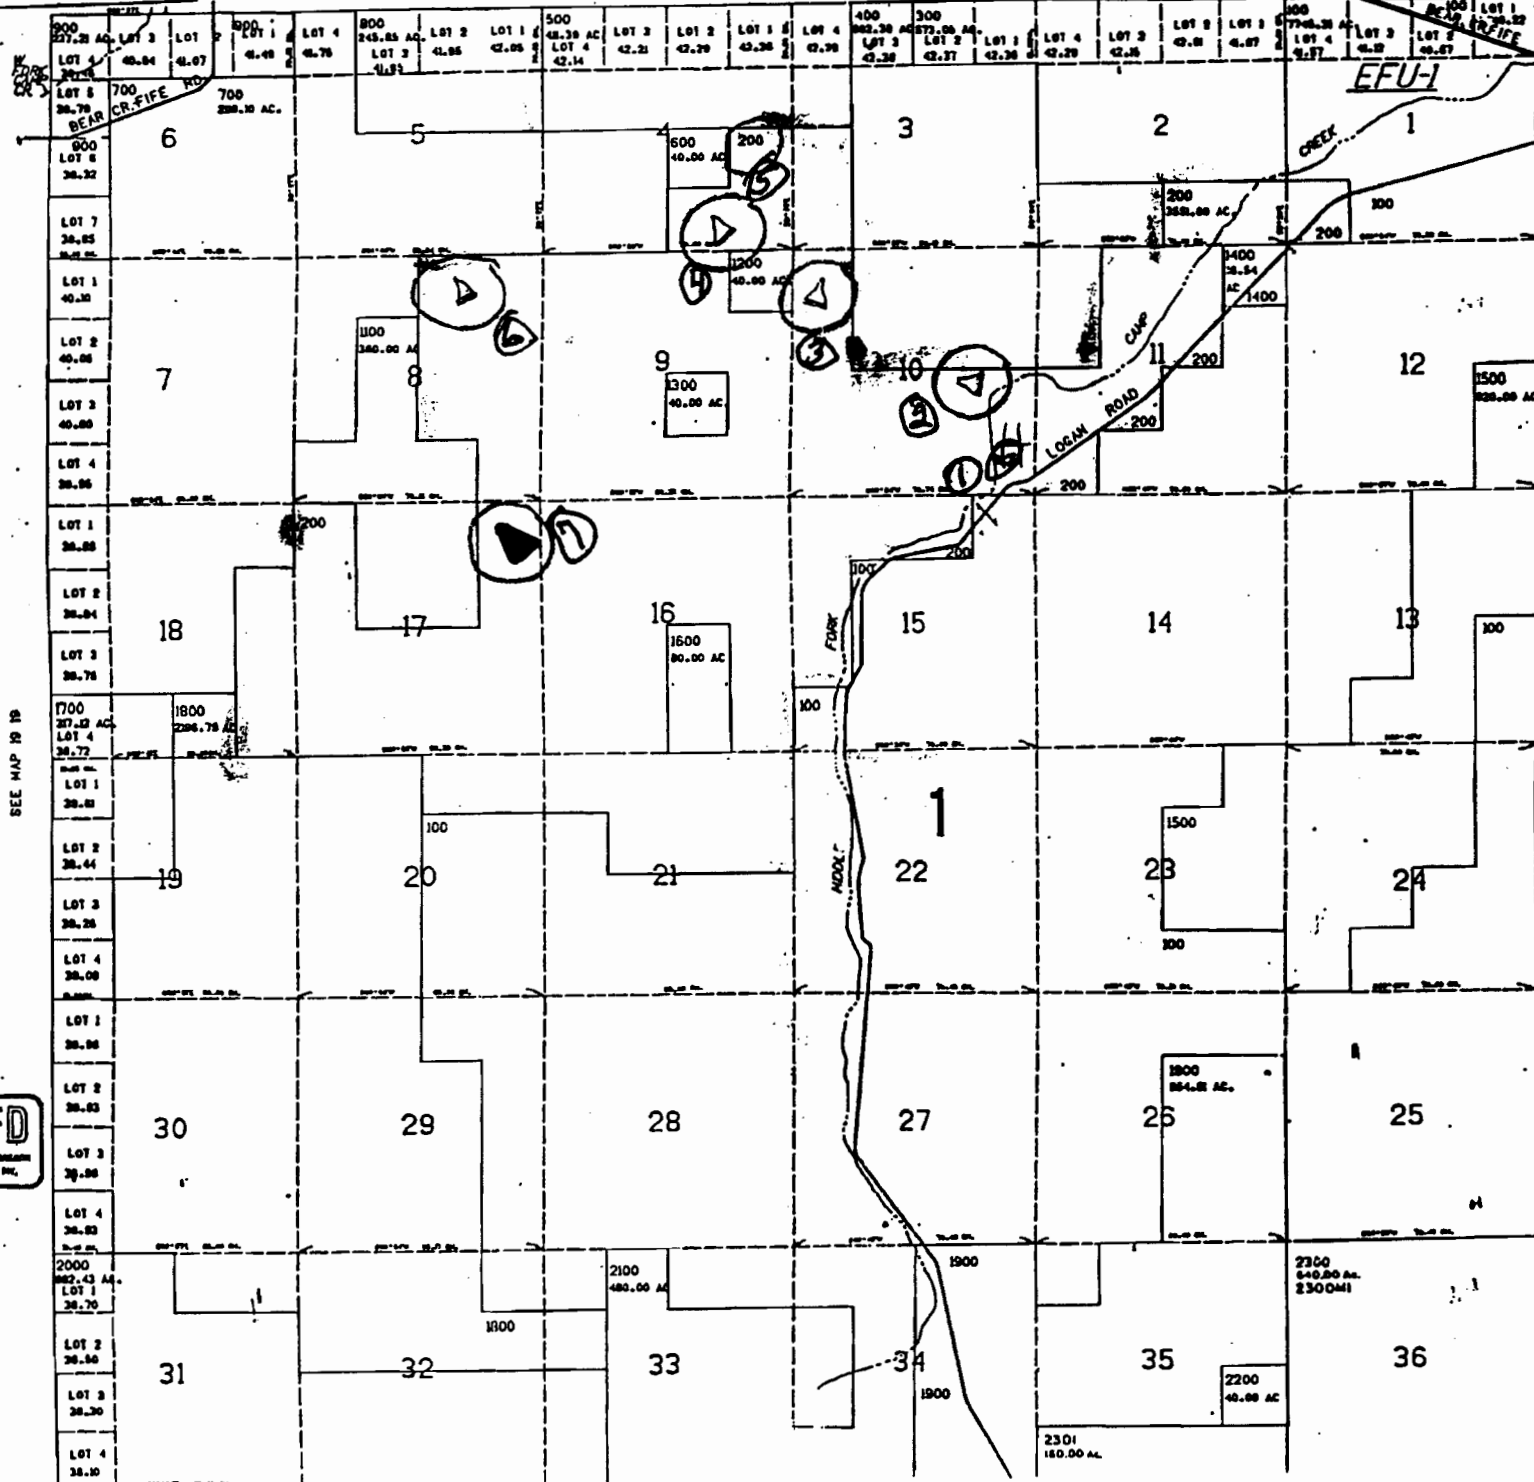

Permit No.

No.

1283613
R-83527

1122403

WATER RESOURCES DEPT
SALEM, OREGON

AUG 11 1997

RECEIVED

RECEIVED
MAR 31 1992
OFFICE OF THE STATE OF OREGON
DESIGNATED APPRAISER, INC.

Over