
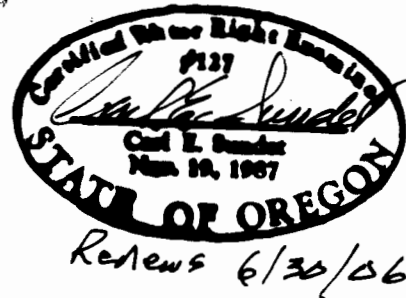



CLAIM OF BENEFICIAL USE MAP
NW 1/4 Section 1, T.27S. R.17E., W.M.
 Lake County, Oregon

Larry and Tara Grassman
T-8580

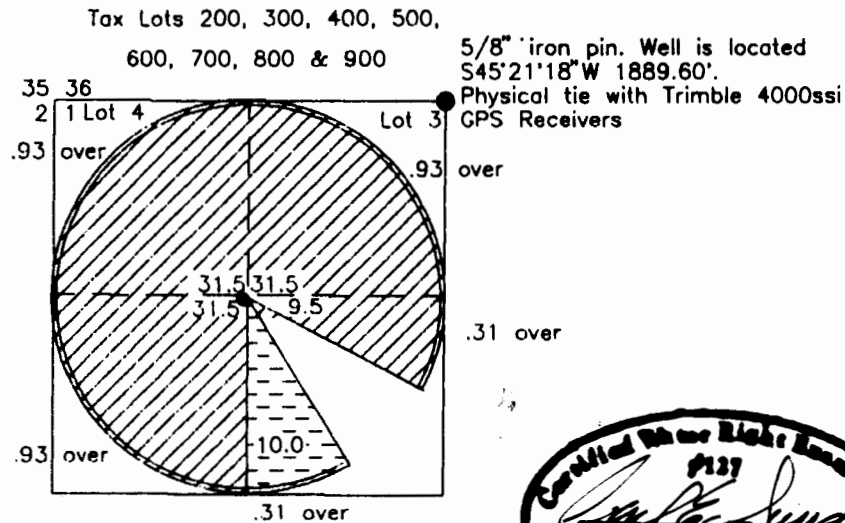

Prepared by: Sundet & Associates
 P.O. Box 1228
 Lakeview, OR 97630
 (541)947-3293

 104 acres transferred from
 Permit G-9355 Cert. 55101

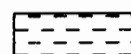 10 acres transferred from
 Permit G-9144 Cert. 75638

This map is for the purpose of identifying the location
 of the water right only and is not intended to provide
 legal dimensions or location of property ownership lines.

Dr # 17104 09-04