

Application No. **R 83609**
R 8352T
 Permit No. **R12412**


RECEIVED

AUG 11 1997

WATER RESOURCES DEPT
 SALEM, OREGON

19 20
 CROOK
 19 20

12 61 47 338

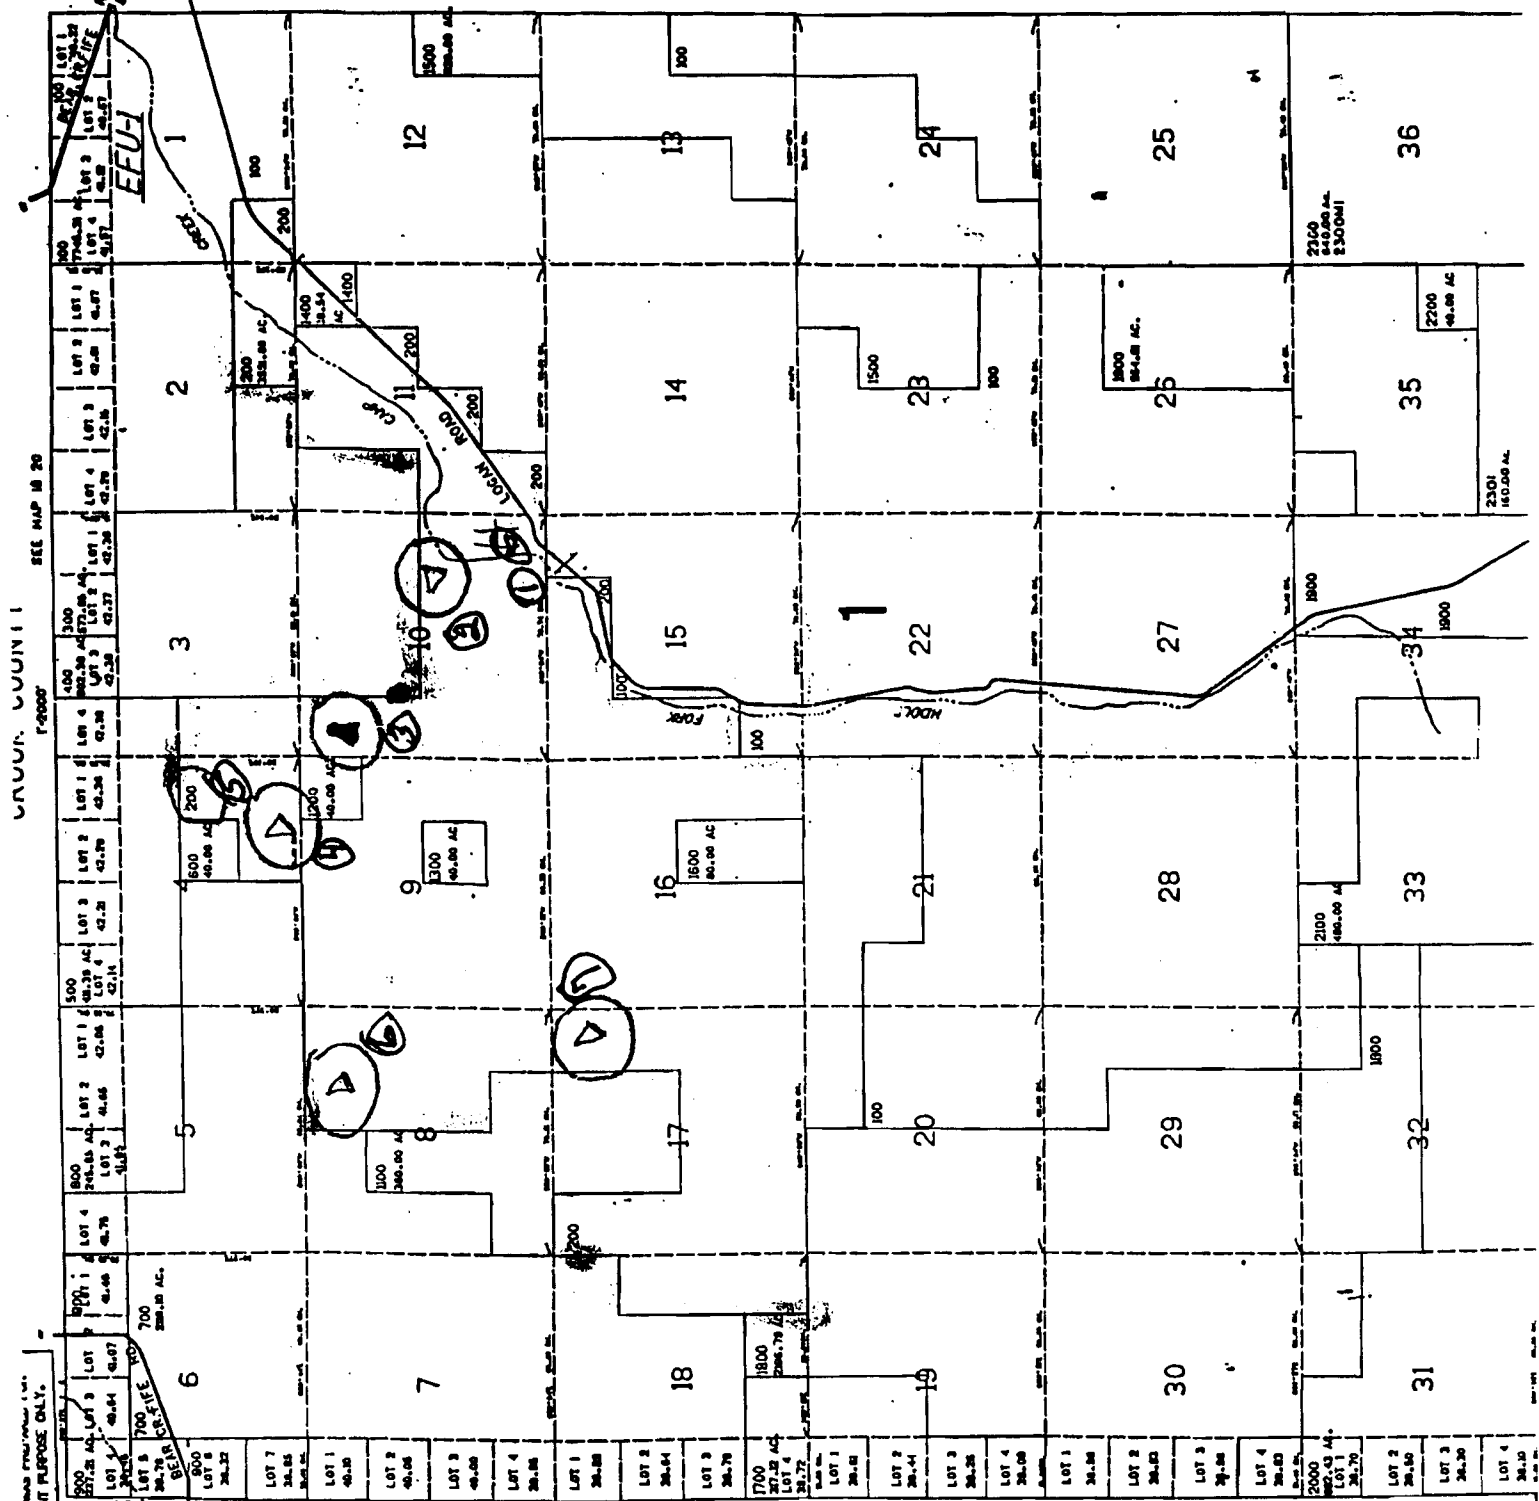

THIS MAP WAS PREPARED FOR
 ASSESSMENT PURPOSE ONLY.

SEE MAP 10 10

RECEIVED
 MAR 3 1992
 CITY OF SALEM, OREGON
 WATER RESOURCES DEPARTMENT

(OVER)