

T. 32 S., R. 6 W., W.M.

SCALE: 1" = 400'



POINT OF DIVERSION IS 803 FEET SOUTH AND 124 FEET WEST OF THE EAST-NORTHEAST CORNER TO DLC NO. 38.

PRIMARY - COW CREEK  
SUPP'L. - GALESVILLE RES.

E.N.E. COR.  
DLC NO. 38

THE PURPOSE OF THIS MAP IS TO IDENTIFY THE LOCATION OF THE WATER RIGHT. IT IS NOT INTENDED TO PROVIDE INFORMATION RELATIVE TO THE LOCATION OF PROPERTY OWNERSHIP BOUNDARY LINES.

SW of the NE

( OLD PACIFIC HWY. )

COW

CREEK

POINT OF DIVERSION

5.1 AC.

SEC. 35

C 1/4

E 1/4

4.9 AC.

NEW RES.  
2.0 A.F.  
STOCKWATER

COUNTY ROAD NO. 313

INTERSTATE HWY. NO. 5

NW of the SE



EXP. 12/31/2001

FINAL PROOF SURVEY


UNDER

Application No. S-74309  
R-74310

Permit No. 52673  
R-II952

IN NAME OF

JOHN L. and PATRICIA L. KING

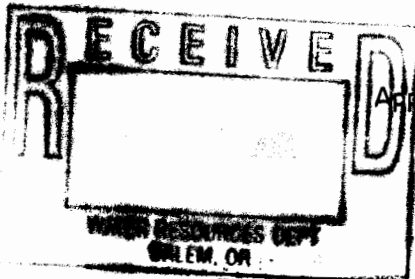

Surveyed; SEPT. 24, 1999

By: R.F. BROWN