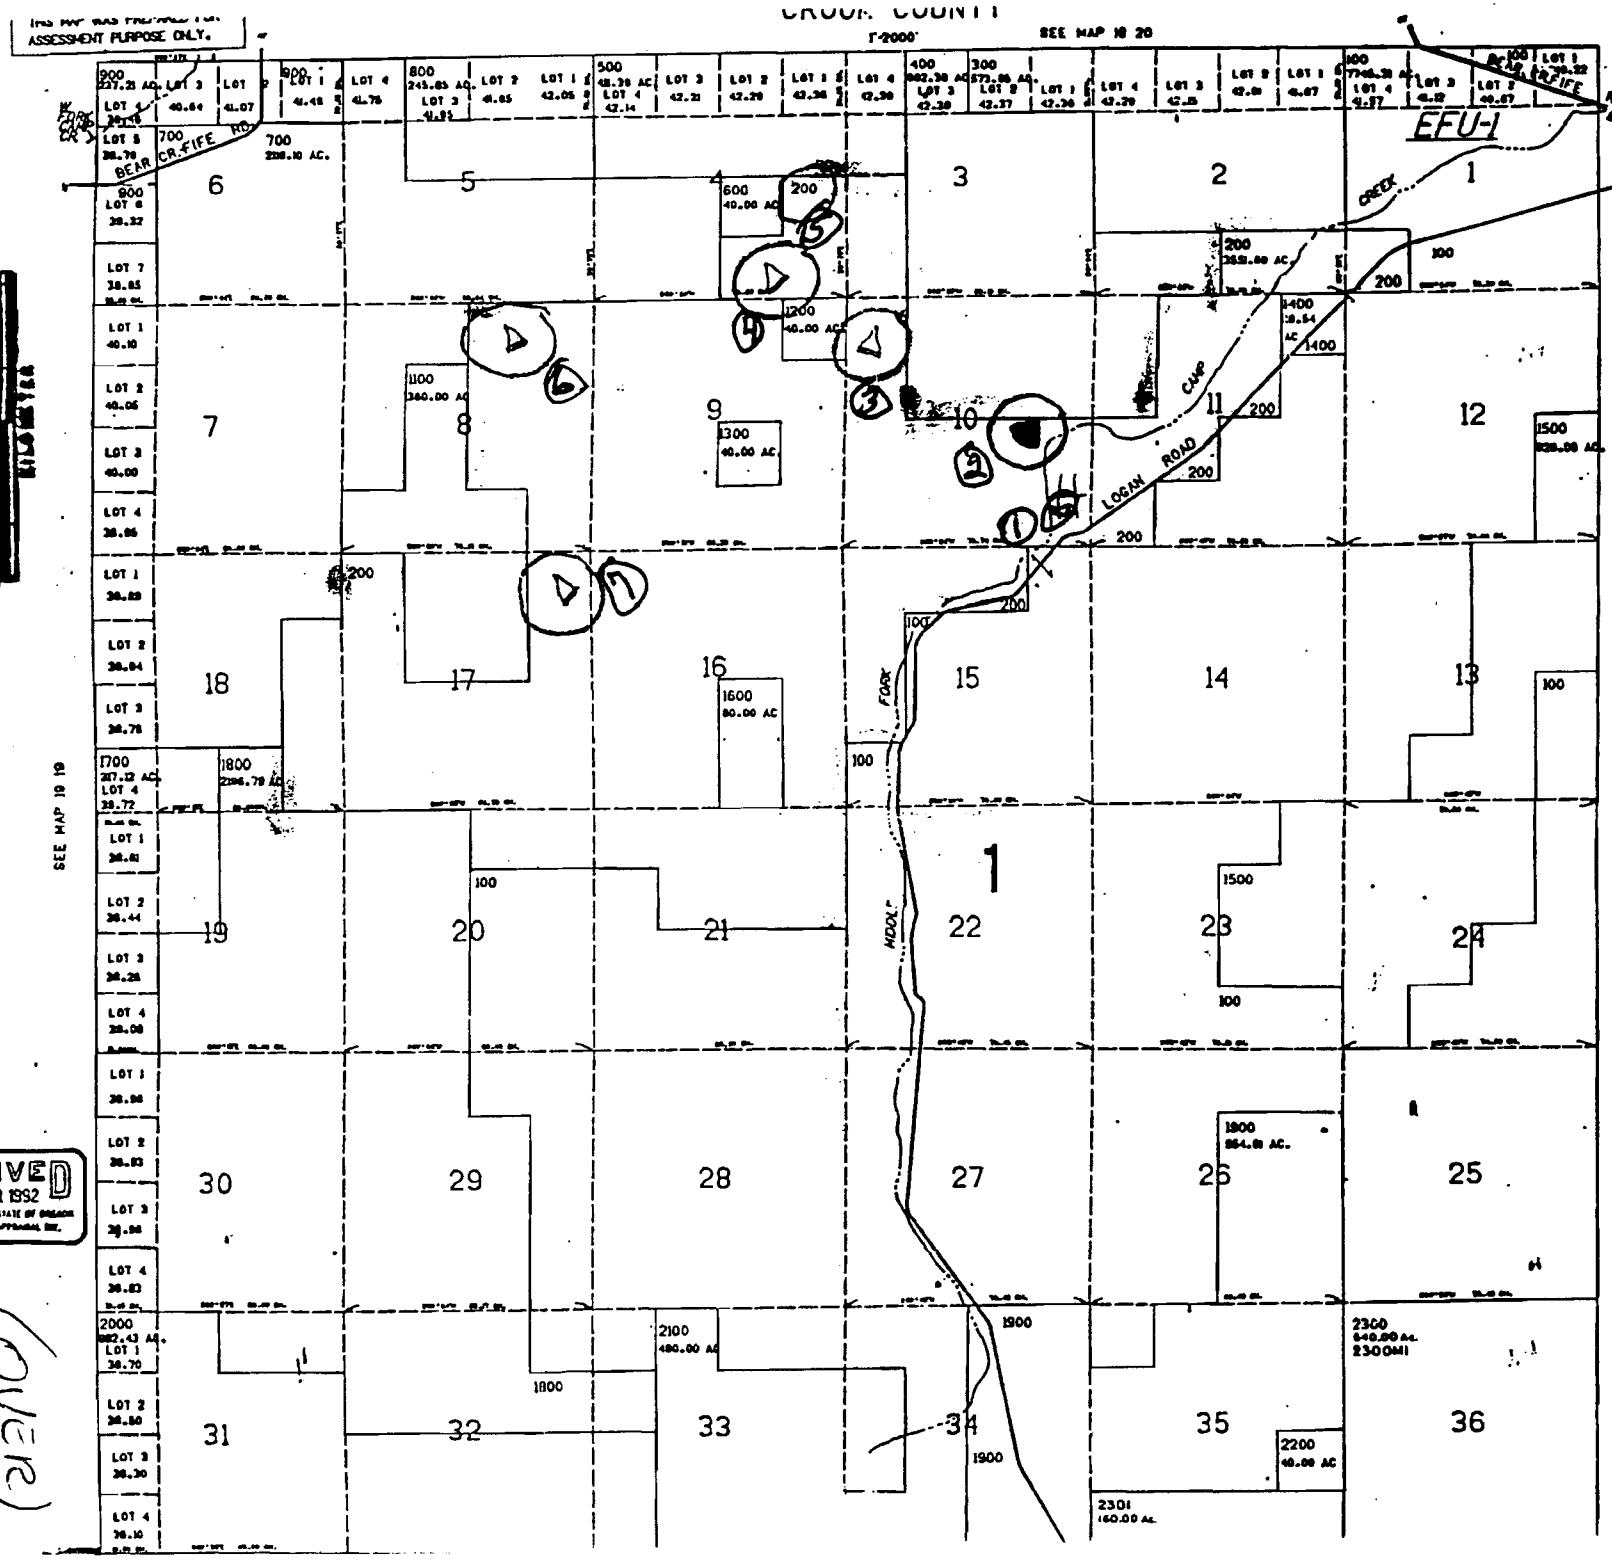

19 20
CROOK
19 20

Permit No. R-12413

RECEIVED
AUG 11 1997
WATER RESOURCES DEPT
SALEM, OREGON