
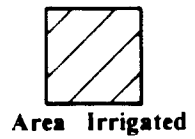


T.7S. R.3W., W.M

RECEIVED

AUG 24 1999

WATER RESOURCES DEPT
SALEM, OREGON

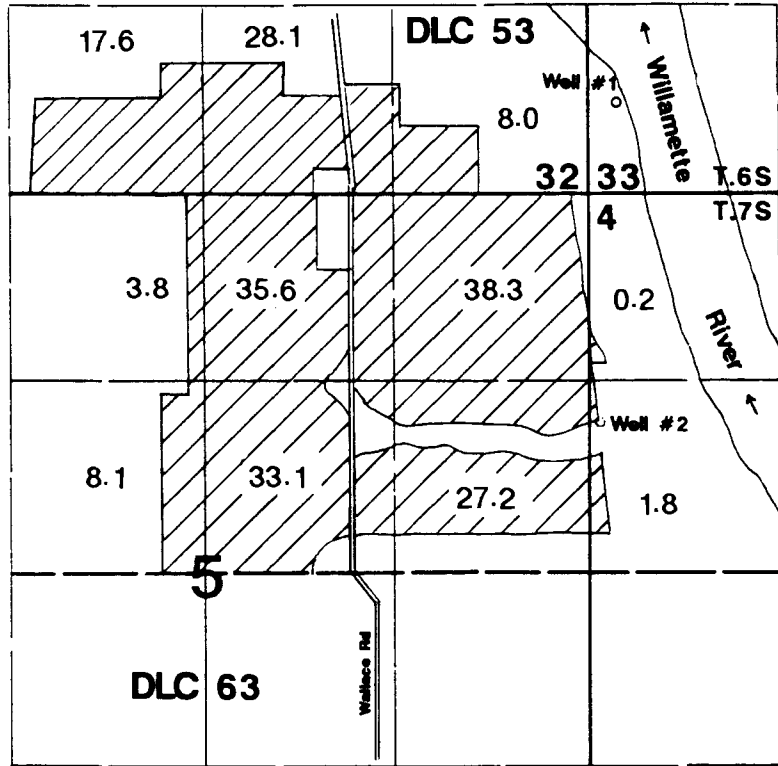

Well #1 is located 640'N & 160'E from the NE corner of Section 5.
Well #2 is located 1580'S & 60'E from the NE corner of Section 5.

Final Proof Survey

Application #: 69945 Permit #: 51718

In Name Of

Mark W. & Carol Gehring

Surveyed on August 9, 1999 by JM Schuette

This Map Was Prepared For The Purpose Of Identifying The Location Of A Water Right Only And Is Not Intended To Provide Legal Dimensions Or Location Of Property Ownership Lines.

