



THIS MAP WAS PREPARED FOR THE PURPOSE OF IDENTIFYING THE LOCATION OF THE WATER RIGHT AND IS NOT INTENDED TO PROVIDE LEGAL DIMENSIONS OR LOCATIONS OF PROPERTY OWNERSHIP LINES.

T2N, R33E, W.M.  
TAX LOT 501 UMATILLA COUNTY

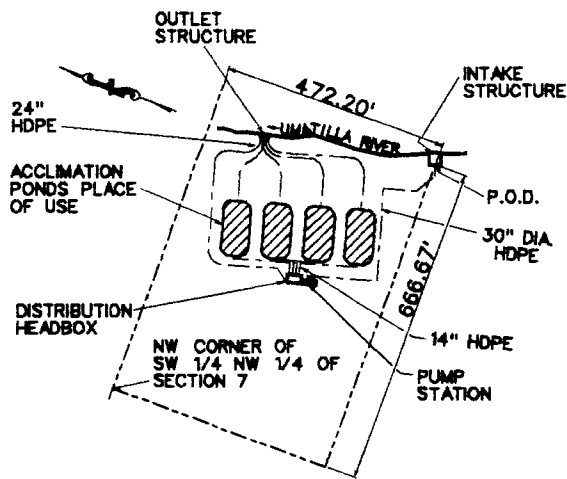

SITE PLAN  
SCALE 1" = 400'

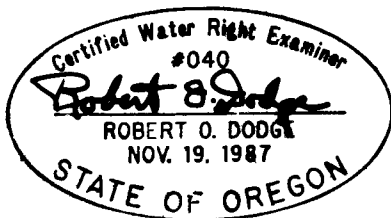

**FINAL PROOF SURVEY  
UNDER**

APPLICATION NO. S-84252 PERMIT NO. 53775

IN NAME OF

OREGON DEPARTMENT OF FISH AND WILDLIFE

SURVEYED: *4/24/02* BY: DODGE