SECTION 17, TWP.1 S. RANGE 14 E. W.M.

WASCO COUNTY, OREGON

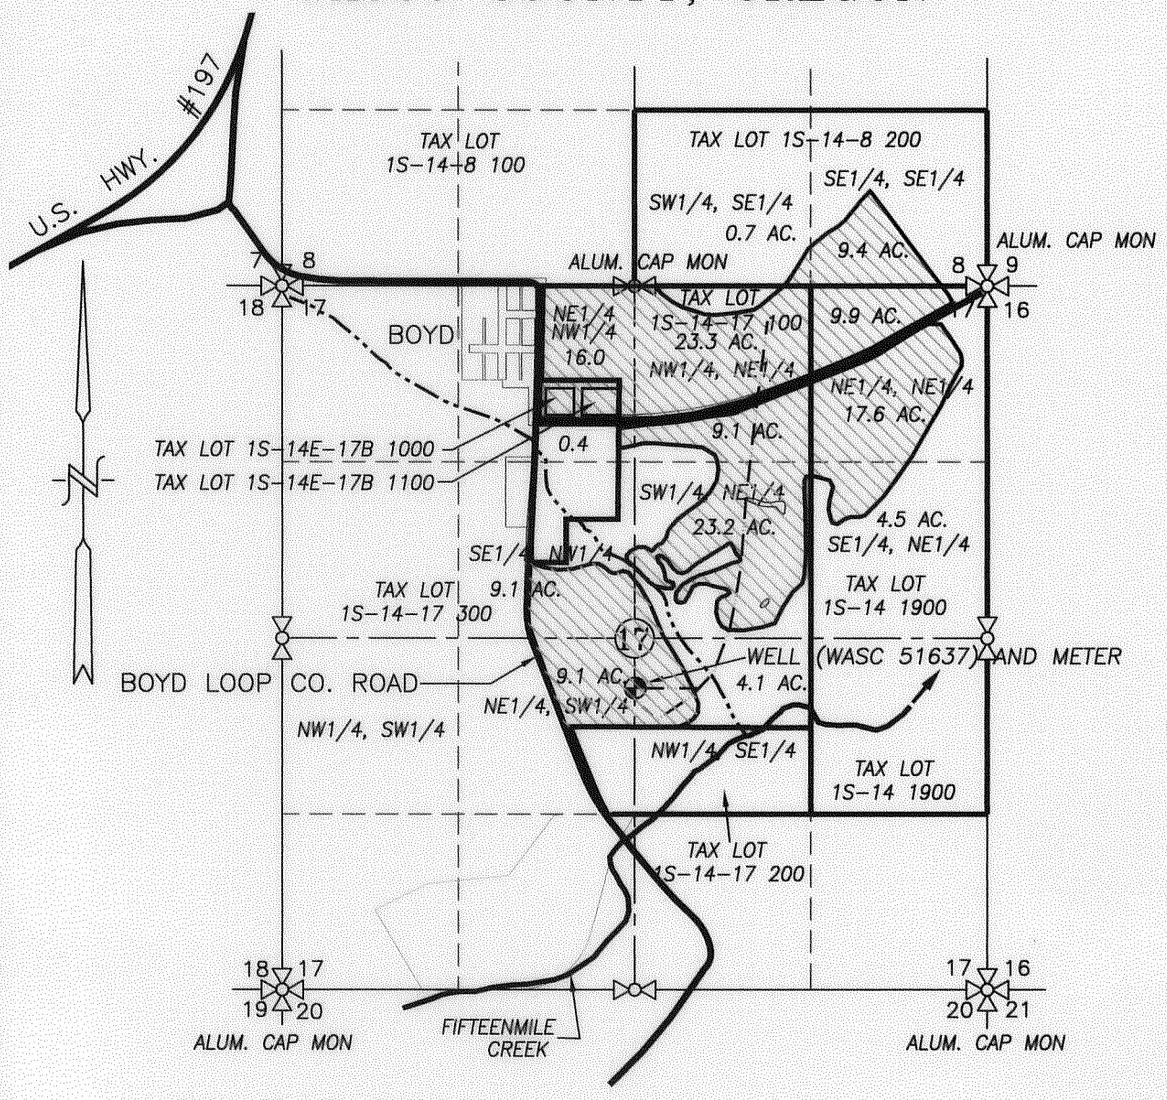

L E G E N D :

WELL (WASC 51637) 2270' N. & 2645' E. OF SW COR. SEC. 17

WATER RIGHT AREA COVERED BY TRANSFER

EXISTING IRRIGATION MAIN

CLAIM OF BENEFICIAL USE MAP

SCALE: 1"= 1320'

0' 660' 1320' 2640'

RECEIVED
OCT 08 2010
WATER RESOURCES DEPT
SALEM, OREGON

TRANSFER No. 10647

IN THE NAME OF:

DANIEL & MERCEDES BOLTON

DATE: SEPTEMBER 2, 2010

CERTIFIED WATER RIGHT EXAMINER
132
LARRY M. TOLL
NOV. 19, 1987
STATE OF OREGON

EXPIRES: 06/30/2012

BY: *TENNESON ENGINEERING CORP.*

3313 W. 2ND. STREET, SUITE 100
THE DALLES, OREGON. 97058
PH. 541-296-9177
FAX 541-296-6657

NOTE:

"THIS MAP IS NOT INTENDED TO PROVIDE DIMENSIONS OR LOCATIONS OF PROPERTY OWNERSHIP LINES."

W.O. #12952wr