



SECTION 16, T.1 S., R.2 W., W.M.
WASHINGTON COUNTY, OREGON

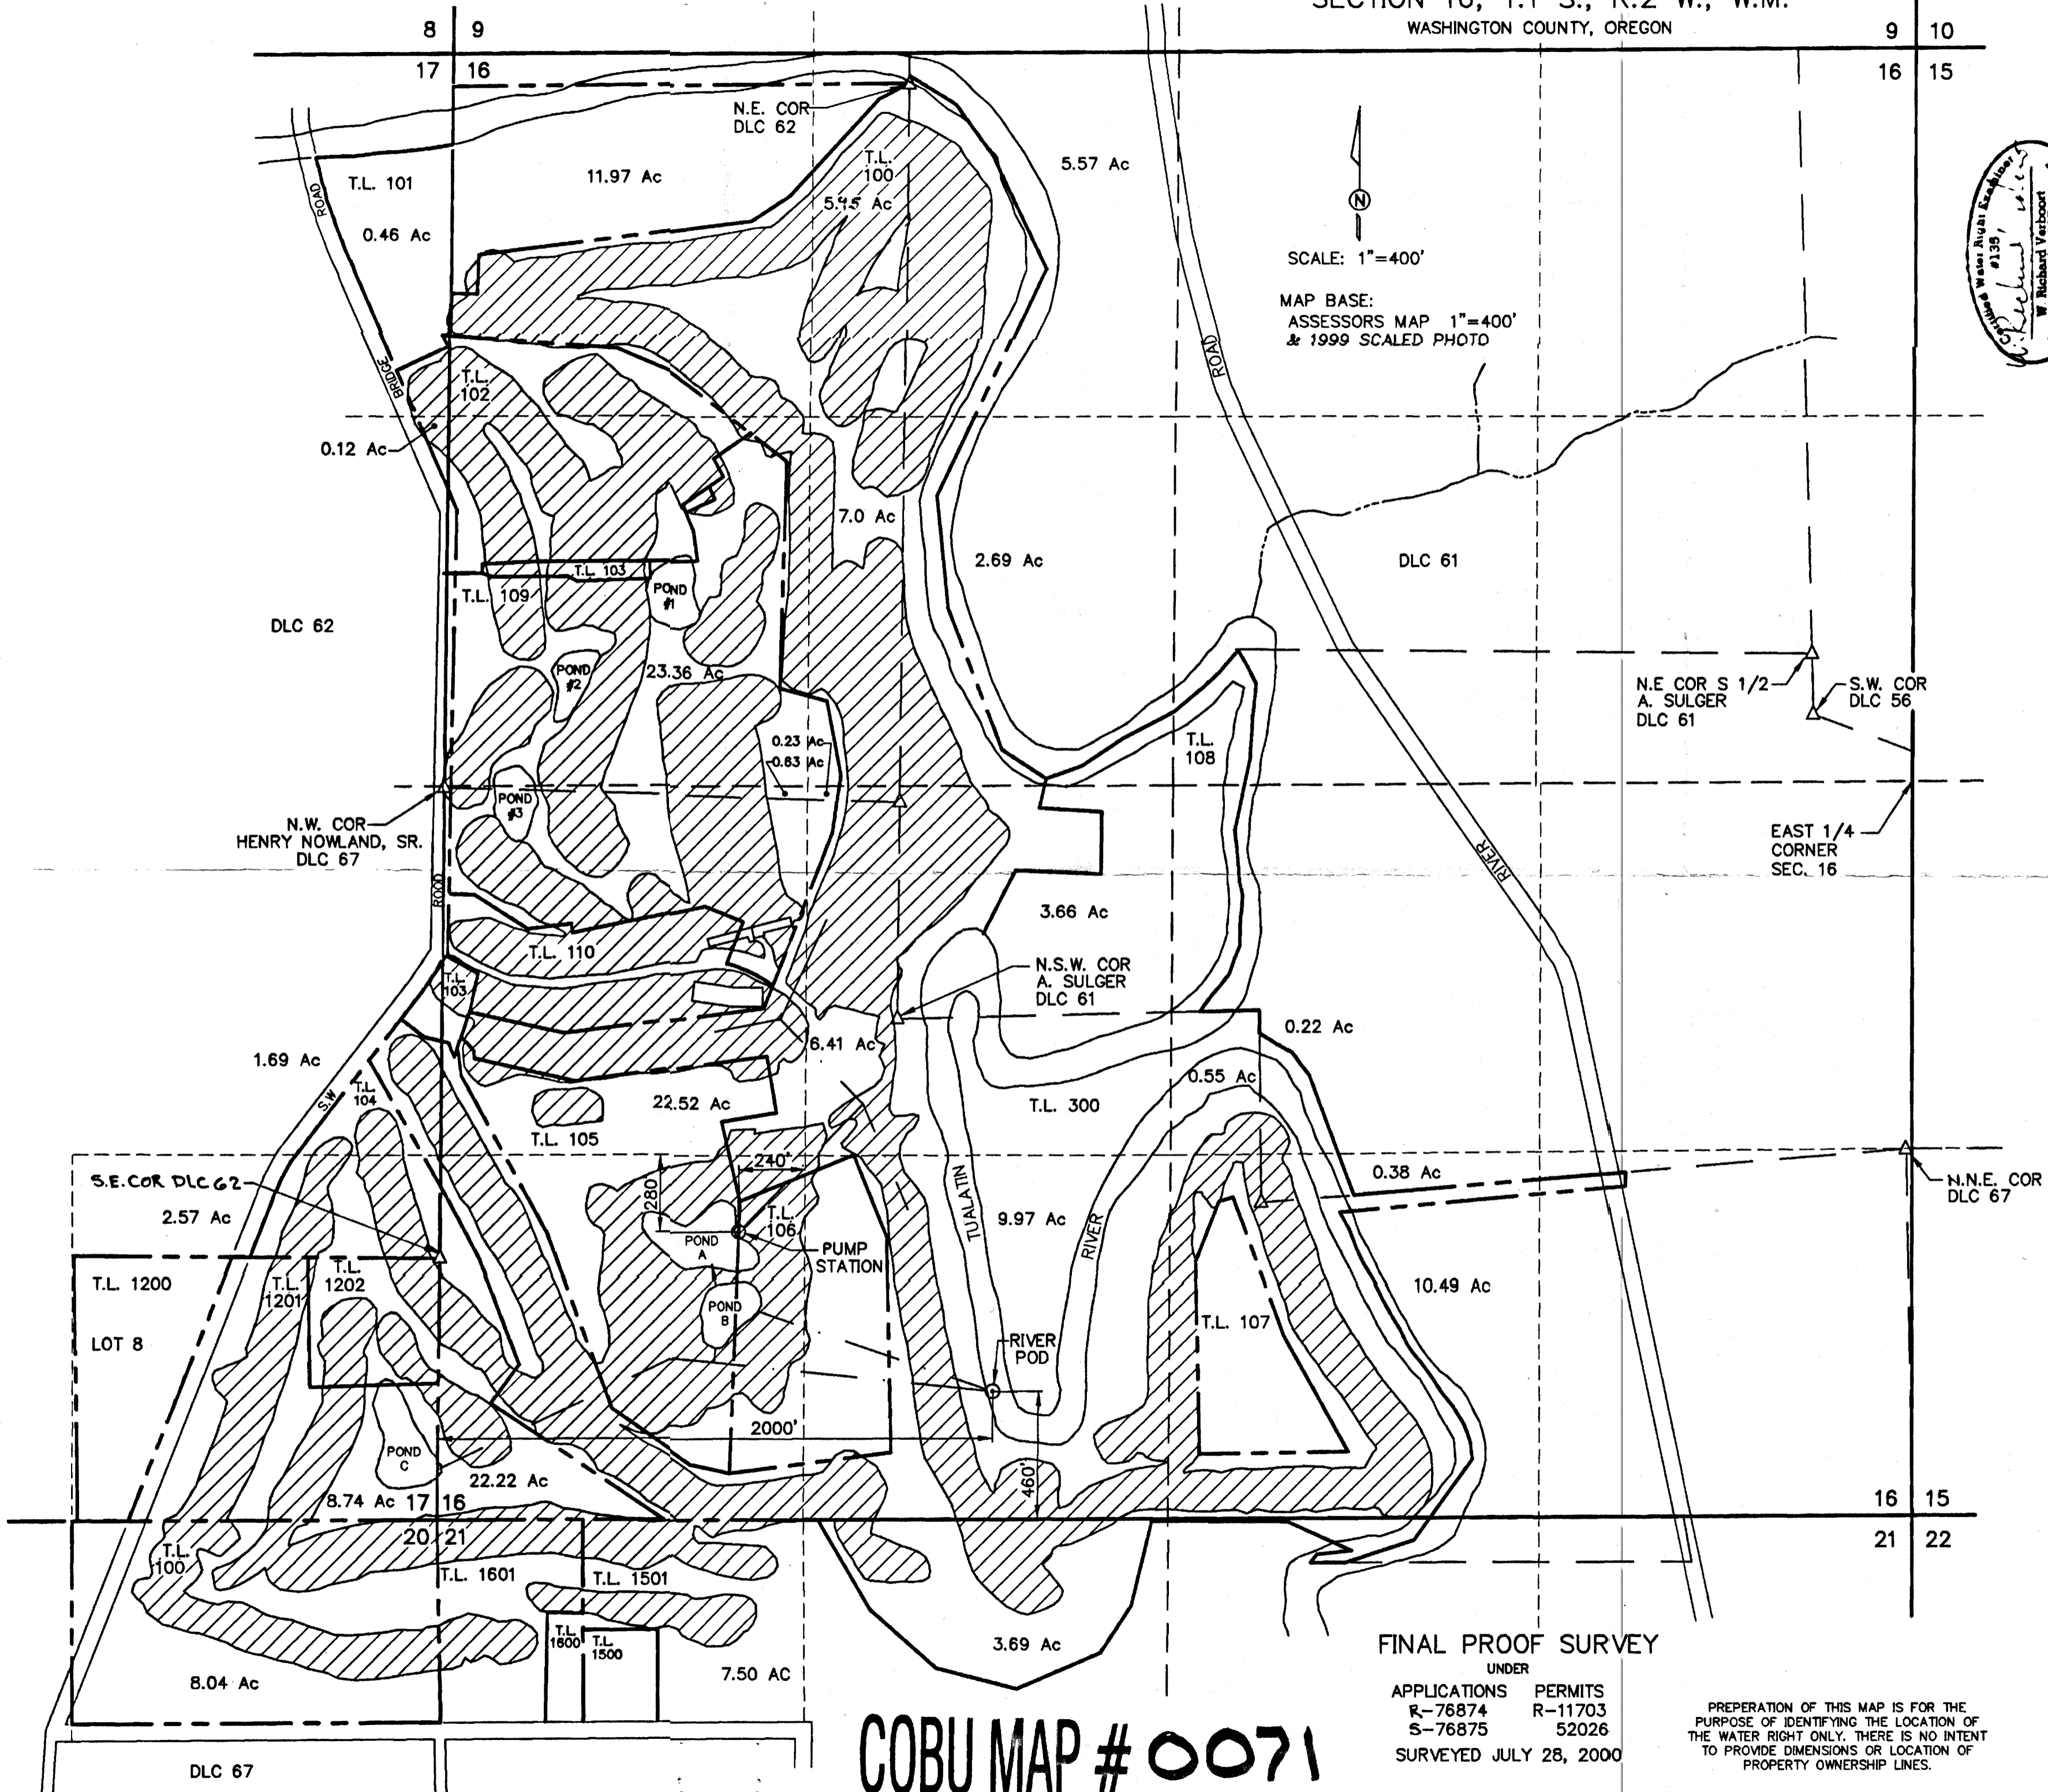

SCALE: 1"=400'
MAP BASE:
ASSESSORS MAP 1"=400'
& 1999 SCALED PHOTO

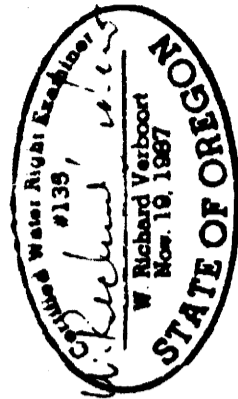

MERIWETHER LIMITED PARTNERSHIP
2155 KALAKAUA AVE., SUITE 410
HONOLULU, HI 96815-2354

date	07/31/00
by	WRV JER WRV
designed	
drawn	
checked	
drawing no.	00-C-02
sheet no.	1 / 1

VERBOORT ENGINEERING
AGRICULTURE · CIVIL · WATER RESOURCES
HILLSBORO, OREGON

COBU MAP # 0071

FINAL PROOF SURVEY
UNDER
APPLICATIONS R-76874 S-76875 SURVEYED JULY 28, 2000
PERMITS R-11703 S-52026

PREPARATION OF THIS MAP IS FOR THE PURPOSE OF IDENTIFYING THE LOCATION OF THE WATER RIGHT ONLY. THERE IS NO INTENT TO PROVIDE DIMENSIONS OR LOCATION OF PROPERTY OWNERSHIP LINES.

0071