


RECEIVED

RECEIVED JUN 16 1997

MAY 11 1998 WATER RESOURCES DEPT.  
SALEM, OREGON  
WATER RESOURCES DEPT.  
SALEM, OREGON

Scale \_\_\_\_\_ Date 8/27/96  
Drawn \_\_\_\_\_  
Checked \_\_\_\_\_

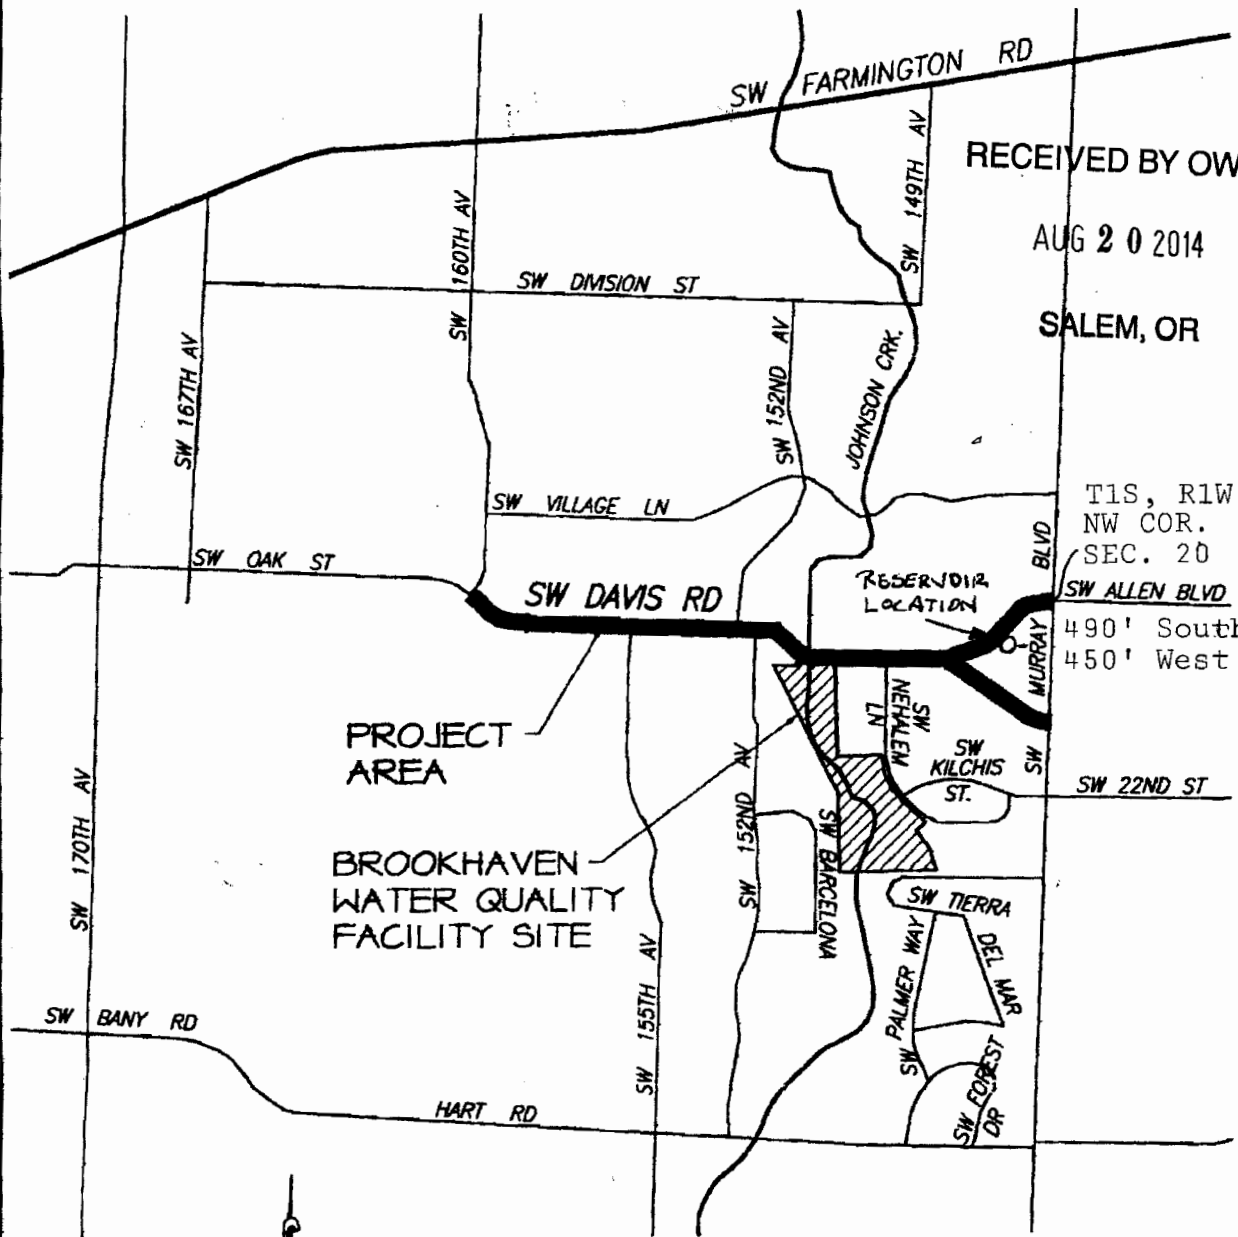

RECEIVED BY OWRD  
AUG 20 2014  
SALEM, OR

T1S, R1W  
NW COR.  
SEC. 20  
490' South  
450' West

PROJECT AREA  
BROOKHAVEN  
WATER QUALITY  
FACILITY SITE

FIGURE 1.1  
VICINITY MAP


DAVIS ROAD  
ENVIRONMENTAL  
ASSESSMENT  
CITY OF BEAVERTON  
BEAVERTON, OREGON

R-83829

R12553



GRAPHIC SCALE

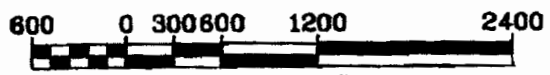

( IN FEET )  
1 inch = 1200 ft.



Sheet No.

Project No. 1325

**RECEIVED**

MAY 11 1998

WATER RESOURCES DEPT.  
SALEM, OREGON

**RECEIVED**

JUN 16 1997

WATER RESOURCES DEPT.  
SALEM, OREGON

Designed	Date
Drawn	Date
Checked	Date

REVISED

APPROX.  
RESERVOIR LOCATION

S. W. Allen Boulevard Extension

Figure 5  
Allen Blvd. Area

6  
Road Area

Wetland J

Wetland A  
TAX LOT 100

Murray Blvd.

BEAVERTON  
TAX MAP 151-20AA

T1W R1S S20 NE 1/4

S.W. Davis Road Improvements  
Wetland Delineation  
Vicinity Map

DAVIS ROAD

CITY OF BEAVERTON  
BEAVERTON, OREGON



ADDISON  
ASSOCIATES INC.



KURAHASHI  
& ASSOCIATES INC.

Figure 4

Sheet No.

1325

Project No.

Application No. R-83824

Permit No. R12553