

CLAIM OF BENEFICIAL USE

APPLICATION NO. 71329 PERMIT NO. 51764

SURVEYED AUGUST 30, 1999 BY DUANE KIRBY


IN THE NAME OF RICHARD L. KIEHN

SECTIONS 22, AND 23, T26S., R6W., W.M.

RECEIVED

SEP 1 1999

WATER RESOURCES DEPT.
SALMON, OREGON

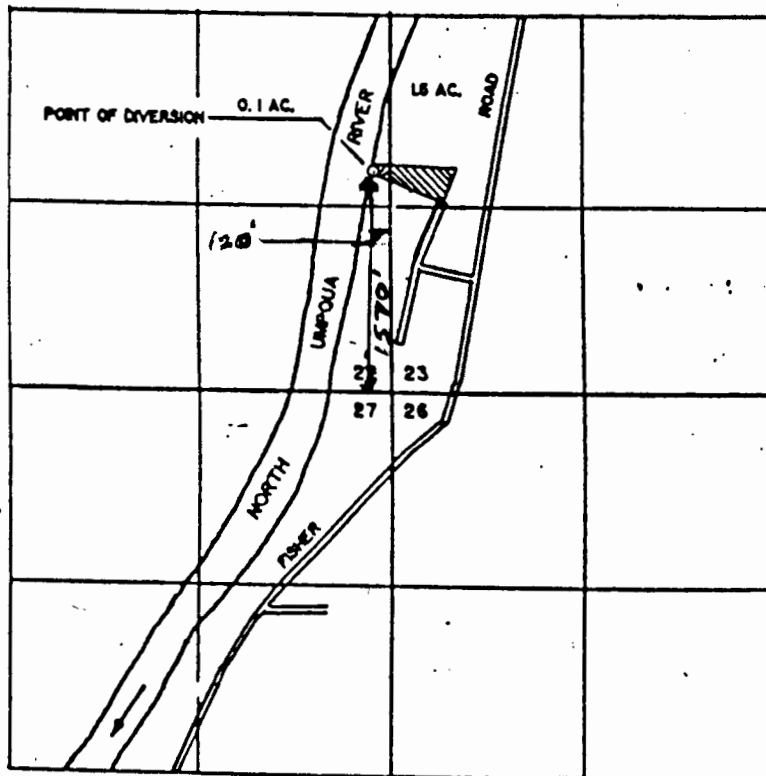

1 INCH = 1320 FEET

THE PURPOSE OF THIS MAP IS TO IDENTIFY THE LOCATION OF THE WATER RIGHT. IT IS NOT INTENDED TO PROVIDE INFORMATION RELATIVE TO THE LOCATION OF PROPERTY OWNERSHIP BOUNDARY LINES.

