

307
22732
1522
5

400
14.72 Ac.

010241

F.F-10

RECEIVED

FEB - 2 1998

WATER RESOURCES DEPT.
SALEM, OREGON

T2S R5E 34 NW/4

106
5.63 Ac.
22775

46-04

501
12.56 Ac.
23150

600
19.67 Ac.
46575

700
39.39 Ac.
47021

83763
R12592


RECEIVED BY OWRD

JUL 11 2014

SALEM, OR

502
3.76 Ac.
23434

500
2.77 Ac.
46409

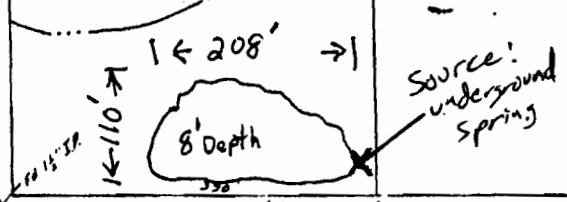

(FRANK)

JAD RNY

COUNT

ALBERT MOTEJL NO. 1 COUNTY ROAD 331 KAKA MC CABE ROAD