


T4S, R2W, WM

MARION COUNTY

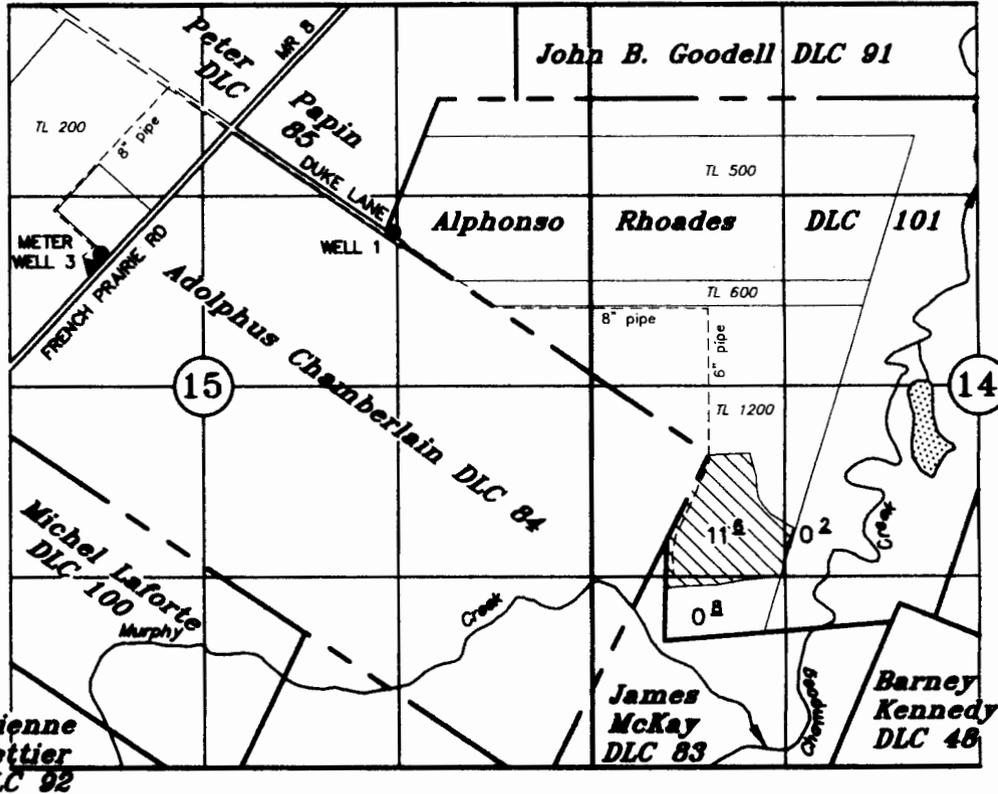

TAX LOTS:
 4 2W 15 200
 4 2W 14 500
 4 2W 14 600
 4 2W 14 1200

WELL 1: 1545' N AND 2150' W OF THE NE COR ADOLPHUS CHAMBERLAIN DLC 84
 WELL 1 METER: NONE REQUIRED, NONE INSTALLED
 WELL 3: 1398' N AND 4137' W OF THE NE COR ADOLPHUS CHAMBERLAIN DLC 84
 WELL 3 METER: 9' SW OF WELL NO. 3

Claim of Beneficial Use

UNDER


Transfer No. T-11556

IN THE NAME OF

A & R Spada Farms, LLC

AUGUST 25, 2014

SCALE: 1" = 1320'

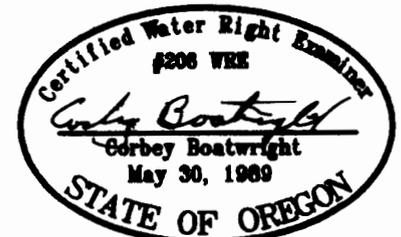

NOTE: This map is not intended to provide legal dimensions or locations of property ownership lines.

Renewal Date: December 31, 2015