


T12S, R6W, W.M. Section 22

OLD POD 2 SPRINGS IN
SE4 NW4 SEC 22
TRIBUTARY OF HENERY CREEK


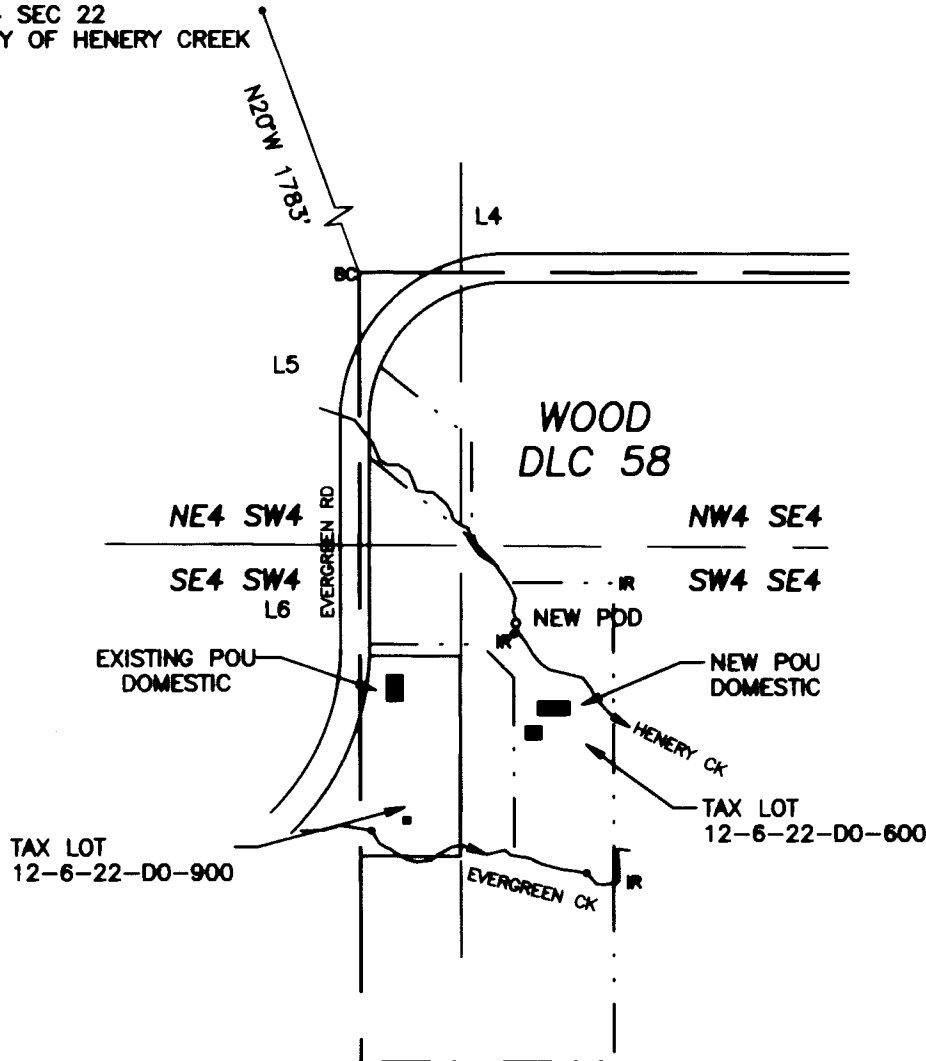


OLD POD: N 1670' & W 610' FROM NW COR DLC 58
NEW POD: S 730' & E 320' FROM NW COR DLC 58

TRANSFER APPLICATION MAP
FOR
LEONARD ROSI & PATRICIA MULDER
CERTIFICATE #24507
TO
RICHARD K & NANCY I RALEIGH

PARSONS SURVEYING
1915 SE Stone St
Corvallis, OR 97333
(541) 752-7515
Project: 0228
Surveyed: 10/9/2002

NOTE: This map is for the purpose of identifying
the location of a water right and does not dimension
or locate property ownership lines

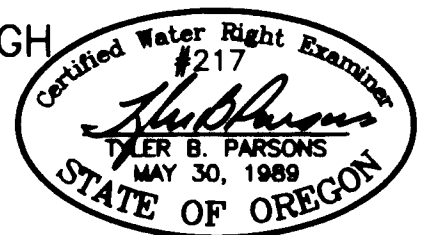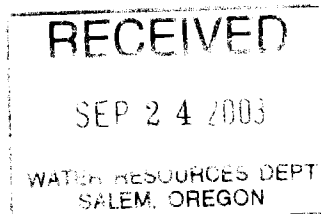

EXP: 12/31/2004

T 9559