


Township 4 North, Range 25 East, W.M.

N 1/2 NW 1/4 of Section 15

MORROW COUNTY

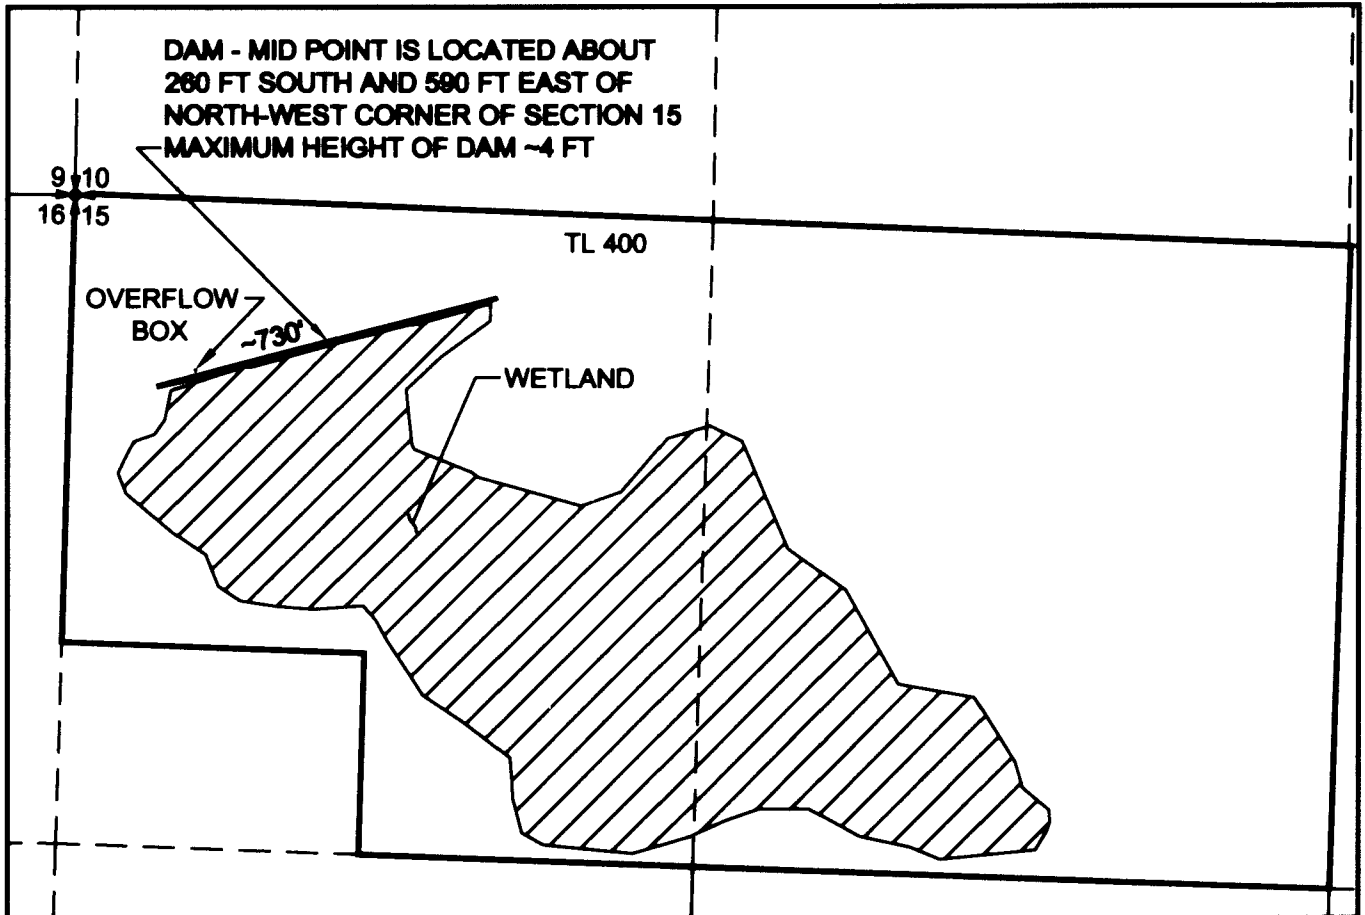

SCALE
1" = 400'

FINAL PROOF SURVEY

under

Permit R-12598

in the name of

Debora L. Wood

September 22, 2014

LEGEND



WETLAND AREA

TL 400


TAX LOT NUMBERS



TAX LOT BOUNDARY



Q-Q SECTION LINES

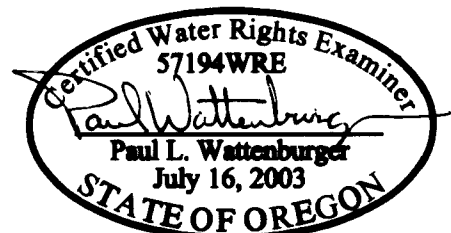

THIS MAP WAS PREPARED FOR THE PURPOSE OF IDENTIFYING THE LOCATION OF A WATER RIGHT ONLY AND IS NOT INTENDED TO PROVIDE LEGAL DIMENSIONS OR LOCATION OF PROPERTY OWNERSHIP LINES.

EXPIRES: 6/30/16