

CLAIM OF BENEFICIAL USE MAP

RECEIVED BY OWRD


UNDER APPLICATION R-81936; PERMIT R-12614

NOV 24 2014

NW1/4 NW1/4 SEC 35 T 40S R 43E W.M.

SALEM, OR

U.S.G.S. QUAD - TEN MILE RANCH, OREG. - 7 1/2'

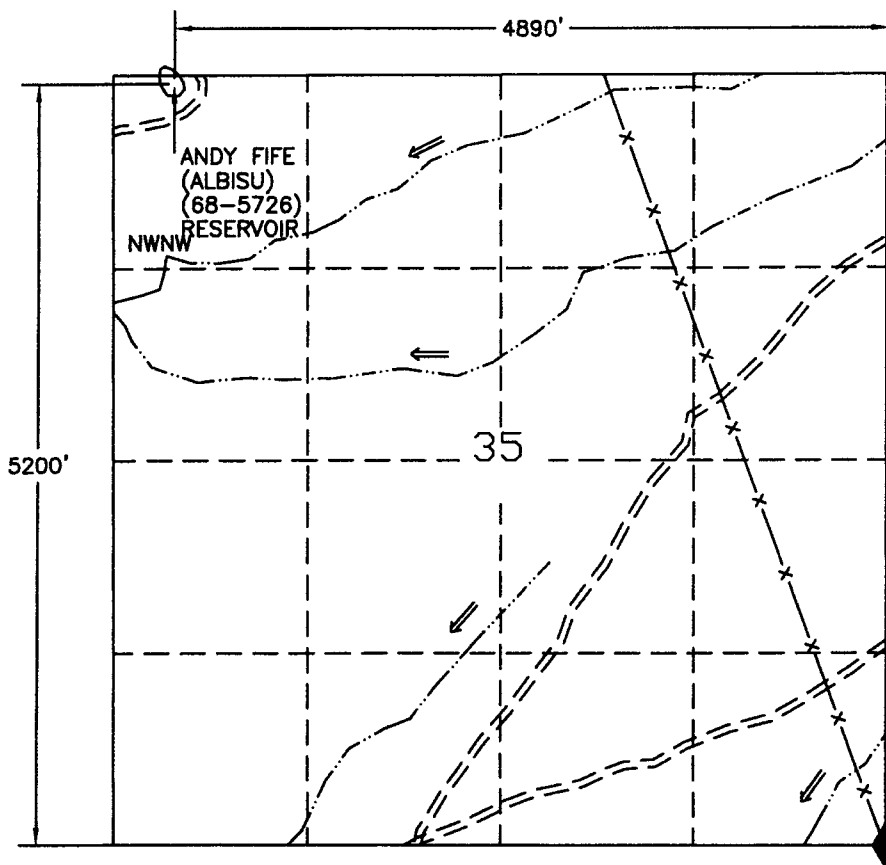


LEGEND

- RESERVOIR
- == ROAD
- CHANNEL
- ◆ FD SEC COR
- x- FENCE



ANDY FIFE (ALBISU) (68-5726) RESERVOIR

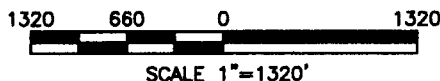

I, Thomas D. Terry, ADM Division of Field Support agree to the findings of the CWRE and do submit this site report and map as my Claim of Beneficial Use of the water as provided under the terms and conditions of my Permit R-12614.

Thomas D. Terry



THIS MAP IS FOR THE PURPOSE OF LOCATING A WATER RIGHT AND IS NOT INTENDED TO PROVIDE LEGAL DIMENSIONS FOR LOCATION OF PROPERTY BOUNDARIES.

ACAD20001
DWG FILE: ANDYFIFE-BENE

UNITED STATES DEPARTMENT OF THE INTERIOR BUREAU OF LAND MANAGEMENT DIVISION OF OPERATIONS VALE DISTRICT	
ANDY FIFE (68-5726) RESERVOIR	
DESIGNED: <i>Thomas D. Terry</i>	
REVIEWED: <i>Don P. Hall</i>	
APPROVED: _____	ADM OPERATIONS AND FIELD SERVICES
DRAWN: CG	SCALE: 1"=1320'
DATE: 08/29/03	SHEET 1 OF 1
DRAWING NO. OR-030-9172.45-1201	