

SECTION 21 T2S R2W W.M.

WASHINGTON COUNTY OREGON

SCALE 1"=400'


RECEIVED BY OWRD

www.co.washington.

DEC 15 2014

SALEM, OR

SEE MAP
2S 2 16

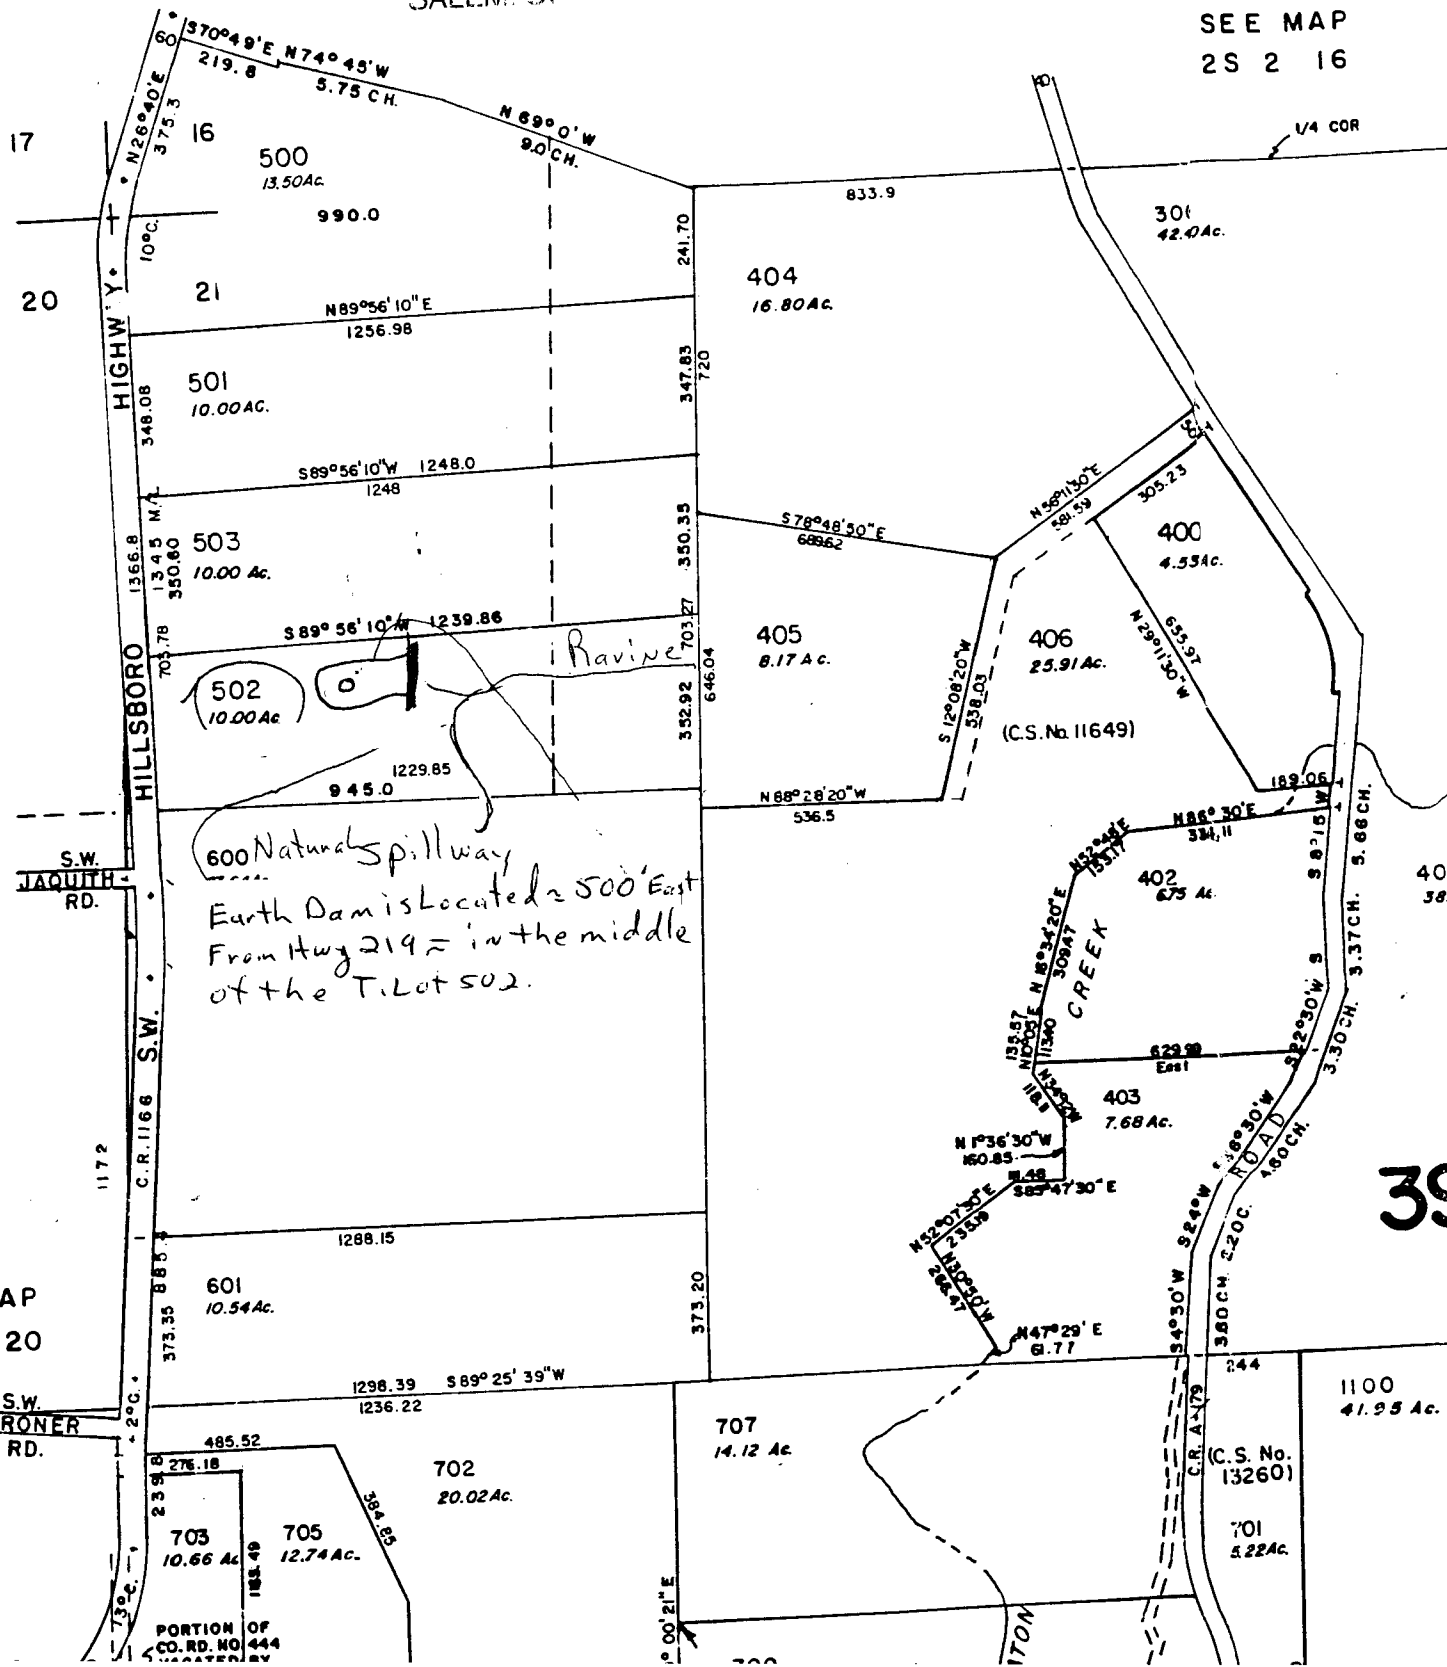

SEE MAP
2S 2 20

35