


RECEIVED BY OWRD

T.20S.R.46E.W.M.

APR 02 2014

SALEM, OR

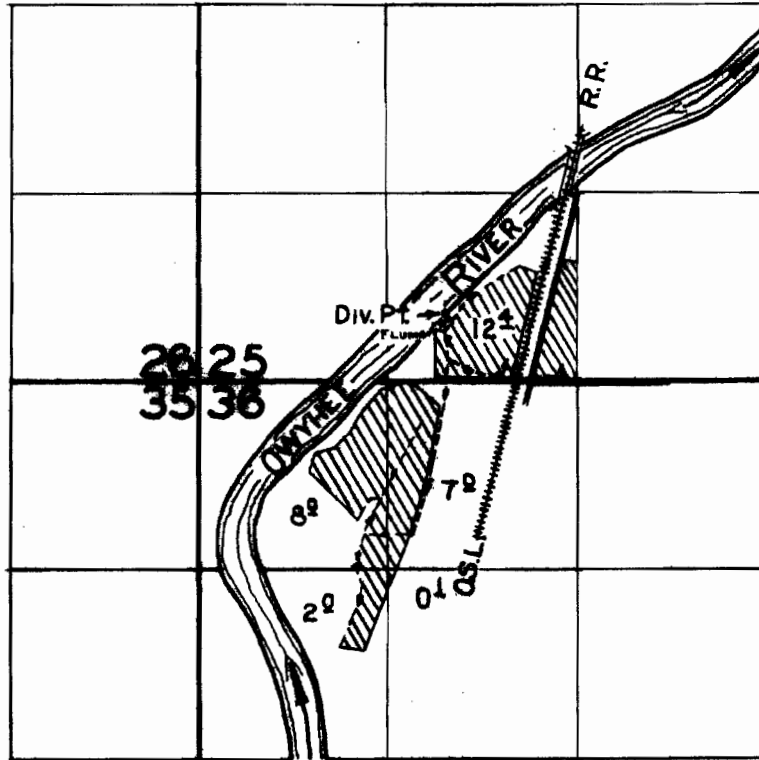

**FINAL PROOF SURVEY**  
UNDER

Application No. 21107 Permit No. 16542  
IN NAME OF

ARCHIE D. MOSES

Surveyed Oct. 26, 1960, by M. BISH

1960-F