

# CLAIM OF BENEFICIAL USE


APPLICATION S-86412

PERMIT S-54270

IN THE NAME OF DARYL ROBISON

TOWNSHIP 31 SOUTH, RANGE 15 WEST, W.M.

CURRY COUNTY OREGON

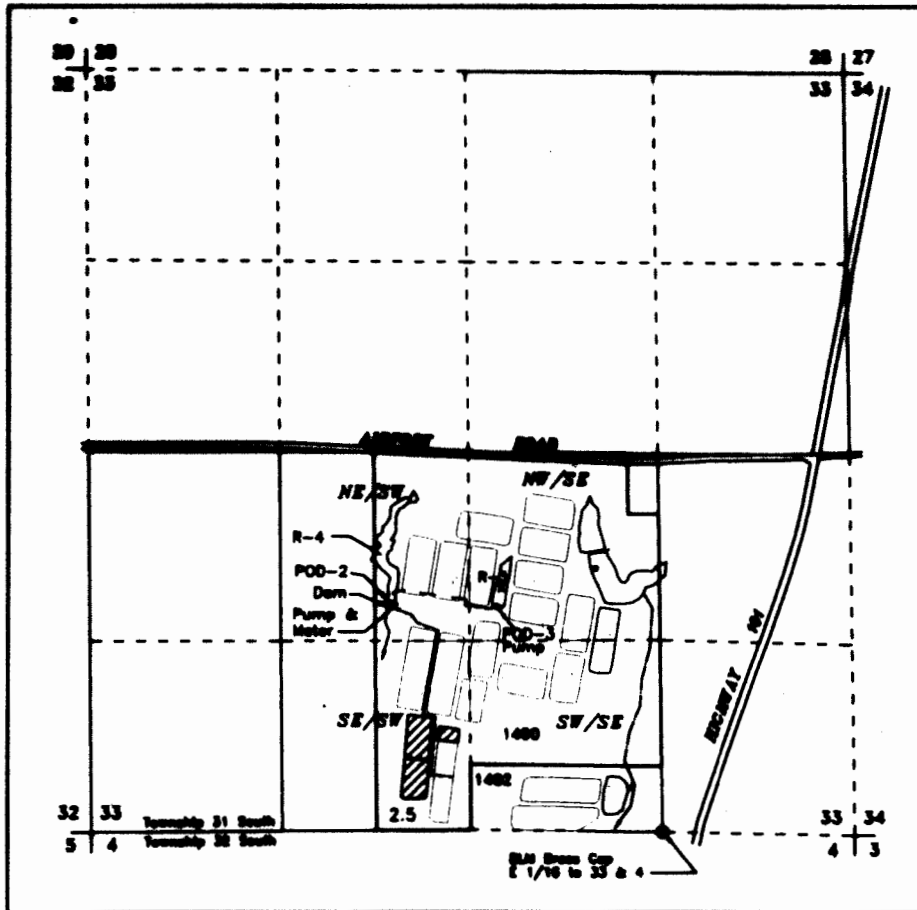

**RECEIVED**

**DEC 16 2011**

**WATER RESOURCES DEPT  
SAIFM OREGON**



Scale

1 inch = 1320 feet



Base map CS 31-178 over  
2005 FSA & 2009 OSU  
aerial photos for assumed  
best fit

POD-2 (Res-4) - NE/SW Section 33, 1560 feet North & 3160 feet West  
from the SE Corner Section 33

POD-3 (Res-3) - NW/SE Section 33, 1540 feet North & 2430 feet West  
from the SE Corner Section 33 (Portable Pump)

R-3 - Reservoir 3

R-4 - Reservoir 4



Cronberry Operations  
2.5 Acres TL-1400



Mapped from field  
inspection June 1, 2011

**JORDAN ENGINEERING**  
460 JORDAN LANE  
ROSEBURG, OR 97471  
(541) 673-1931

R3 - 11/16/2011 n.e.d.

This map is not intended to provide legal dimensions  
or locations of property ownership lines