


**FINAL PROOF SURVEY MAP
IN THE NAME OF DUANE B. LINDSAY**

APPLICATION G-13251
R-73170
S-73171

PERMIT G-13018
R-11880
52604

SECTION 13, TOWNSHIP 29 SOUTH, RANGE 15 WEST, W.M.

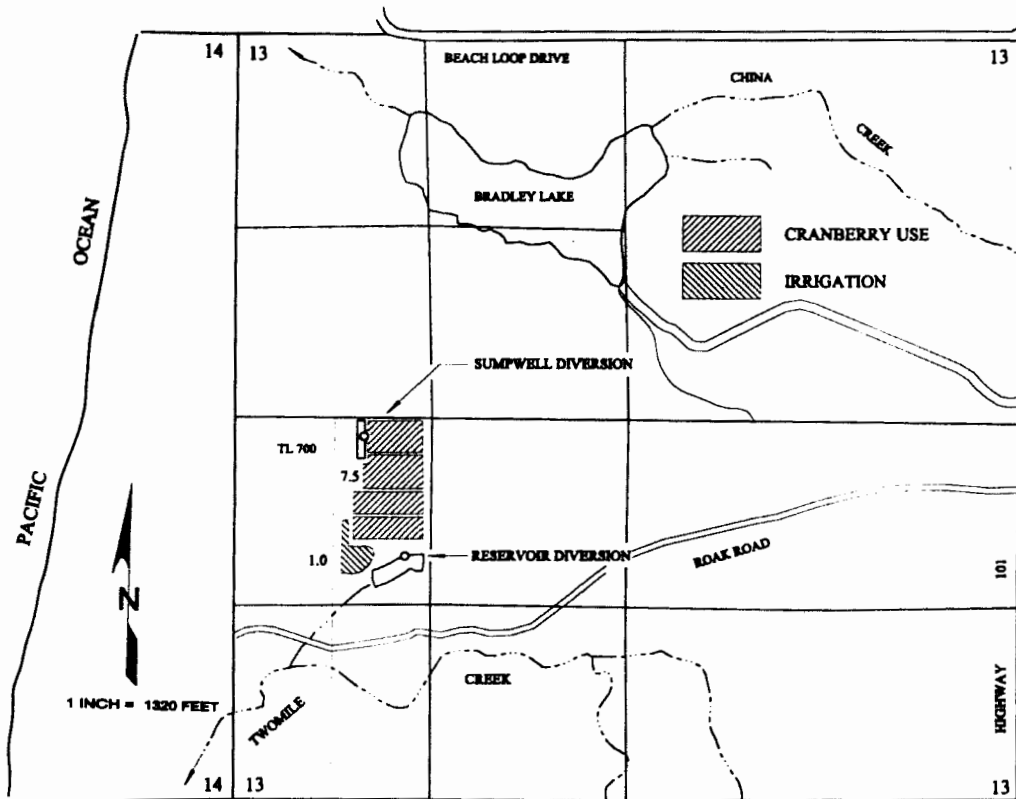

THE SUMPWELL POINT OF DIVERSION IS LOCATED 140 FEET SOUTH AND 890 FEET EAST; AND THE RESERVOIR POINT OF DIVERSION IS LOCATED 970 FEET SOUTH AND 1180 FEET EAST, BOTH FROM THE EAST QUARTER CORNER OF SECTION 13, BEING WITHIN THE NW¹/₄SW¹/₄ OF SECTION 13, TOWNSHIP 29 SOUTH, RANGE 15 WEST, W.M.; COOS COUNTY.

RECEIVED

SEP 27 2000

WATER RESOURCES DEPT.
SALEM, OREGON

THE PURPOSE OF THIS MAP IS TO IDENTIFY THE LOCATION OF THE WATER RIGHT.
IT IS NOT INTENDED TO PROVIDE INFORMATION RELATIVE TO THE LOCATION OF
PROPERTY OWNERSHIP BOUNDARY LINES.

