


FINAL PROOF SURVEY MAP IN THE NAME OF DUANE B. LINDSAY

APPLICATION G-13251
R-73170
S-73171

PERMIT G-13018
R-11880
52604

SECTION 13, TOWNSHIP 29 SOUTH, RANGE 15 WEST, W.M.

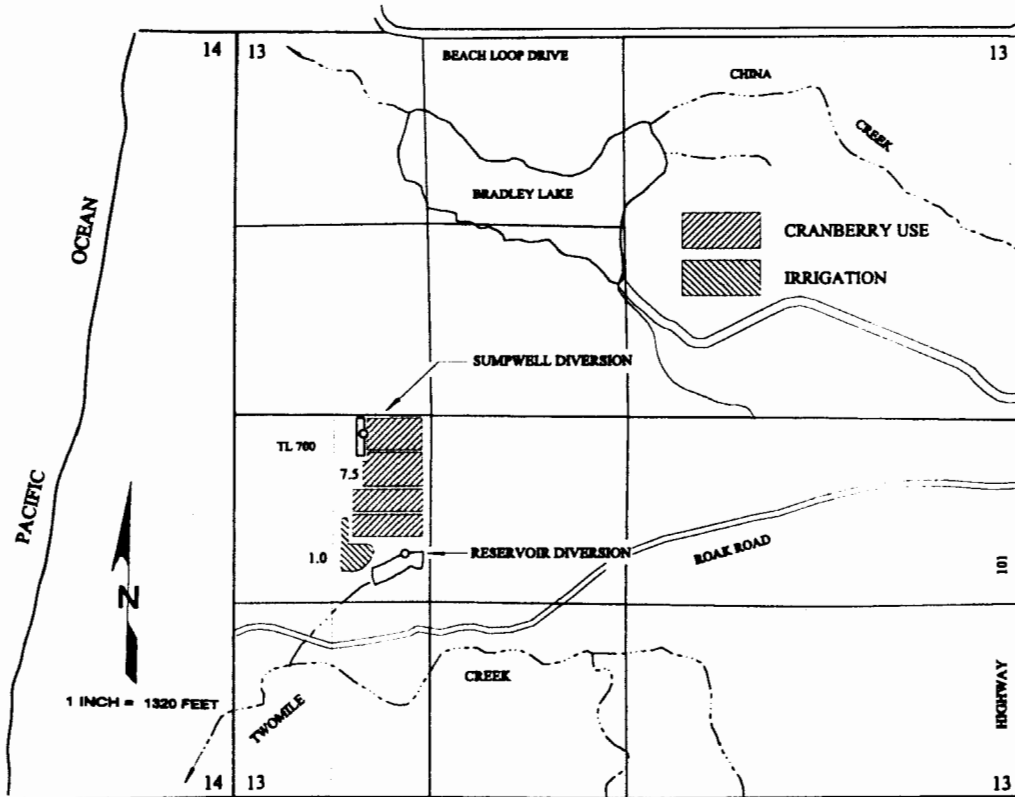

THE SUMPWELL POINT OF DIVERSION IS LOCATED 140 FEET SOUTH AND 890 FEET EAST; AND THE RESERVOIR POINT OF DIVERSION IS LOCATED 970 FEET SOUTH AND 1180 FEET EAST, BOTH FROM THE EAST QUARTER CORNER OF SECTION 13, BEING WITHIN THE NW¹/₄SW¹/₄ OF SECTION 13, TOWNSHIP 29 SOUTH, RANGE 15 WEST, W.M.; COOS COUNTY.

RECEIVED

SEP 27 2000

**WATER RESOURCES DEPT.
SALEM, OREGON**

THE PURPOSE OF THIS MAP IS TO IDENTIFY THE LOCATION OF THE WATER RIGHT. IT IS NOT INTENDED TO PROVIDE INFORMATION RELATIVE TO THE LOCATION OF PROPERTY OWNERSHIP BOUNDARY LINES.

