



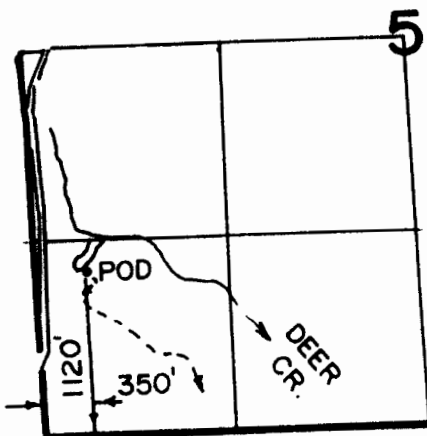

T. 10S., R. 38E., W.M.

The purpose of this map is for identifying the location of the water right only and is not intended to provide legal dimensions of property ownership lines.

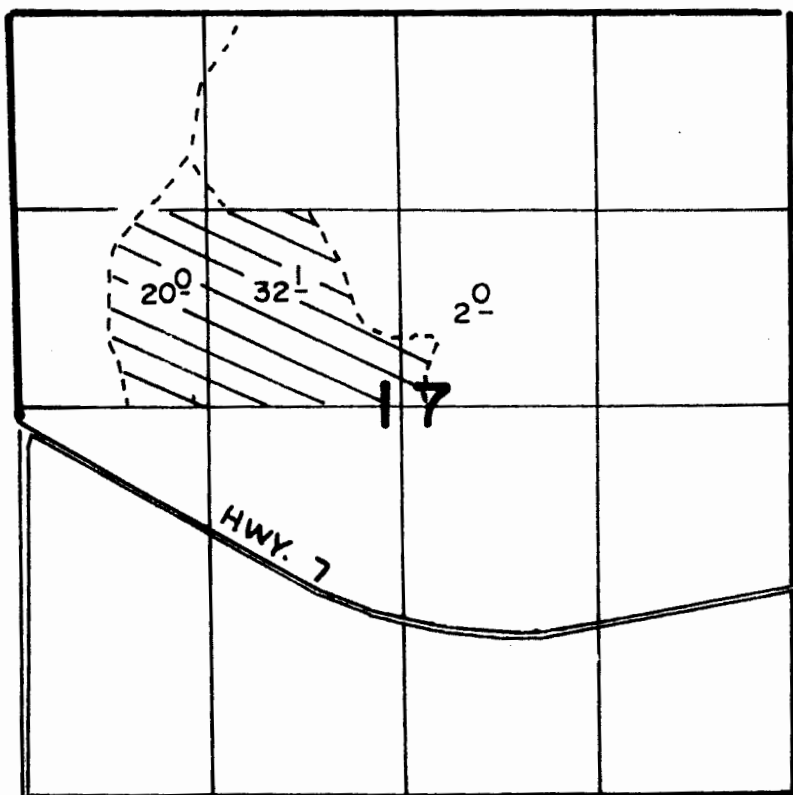

SCALE 1" = 1320'

RECEIVED

OCT 02 2000

WATER RESOURCES DEPT.
SALEM, OREGON

FINAL PROOF SURVEY

APPL. 71059

PER. 52651

IN NAME OF

NORMAN F. HANSEN

SURVEYED

9-13-2000

