



REC'D
JUN 4 2015
OWPD

T.5S., R.1E., W.M.

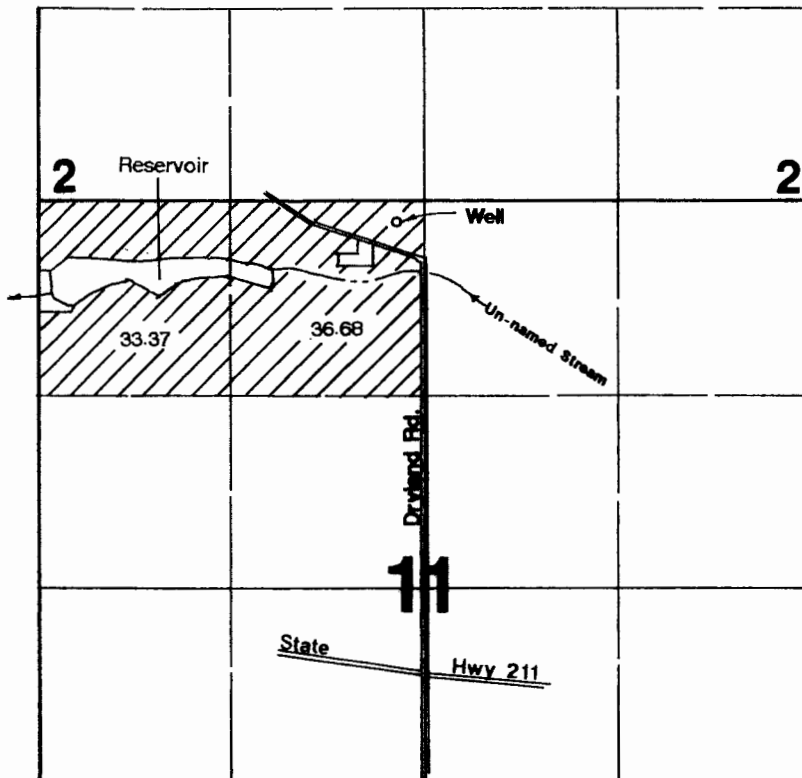

1" = 1320'

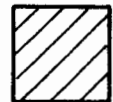

Area Irrigated

Well is located 140'S & 170'W from N¼ corner Section 11.

Final Proof Survey

(Map Revised 2/3/2015 by JM Schuette)

In the Name of

Howard Laney/Cygnet Group

Application #: G-13352 Permit #: G-12258

Surveyed on November 25, 1997 by JM Schuette

This Map was Prepared for the Purpose of Identifying the Location of a Water Right Only and is Not Intended to Provide Legal Dimensions or Location of Property Ownership Lines.



EXPIRES: 6.30.2015