


Township 8 South, Range 2 West, W.M.

S 1/2 NE 1/4, Section 10

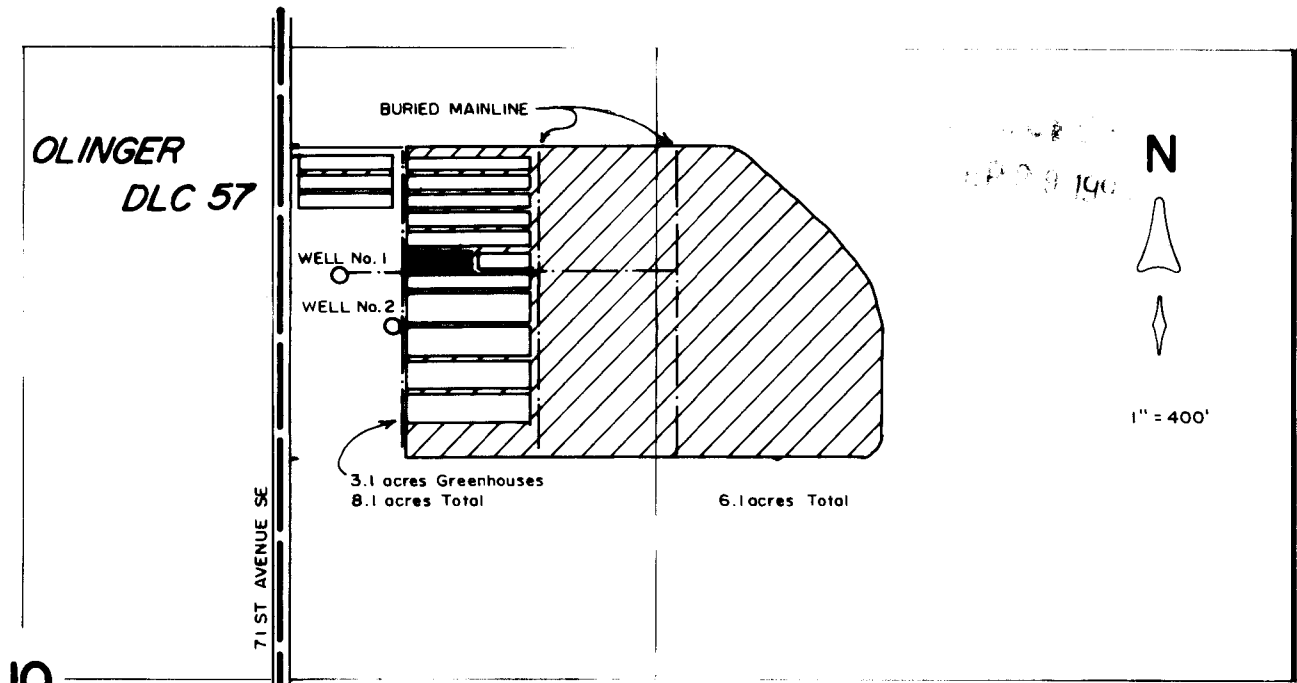


WELLS LOCATED: No. 1, 2450' N. & 120' E,
No. 2, 2350' N. & 230' E. Both from SE cor. DLC 57

FINAL PROOF SURVEY
under
Appl. No. G-12179, Per. No. G-11144
in name of

MARK KRAUTMANN

September 21, 1994

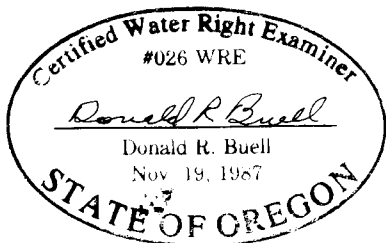

THIS MAP WAS PREPARED FOR THE PURPOSE OF IDENTIFYING THE LOCATION OF A WATER RIGHT ONLY AND IS NOT INTENDED TO PROVIDE LEGAL DIMENSIONS OR LOCATION OF PROPERTY OWNERSHIP LINES.