
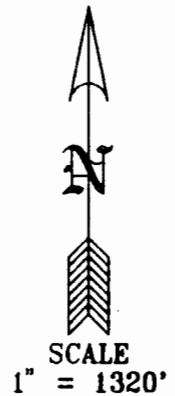


FINAL PROOF MAP
W 1/2 Section 19, T.39S. R.19E., W.M.
Lake County, Oregon

Tax Lot 7906
Application G-13843 Permit G-12661
Steven C. & Nancy C. Albertson

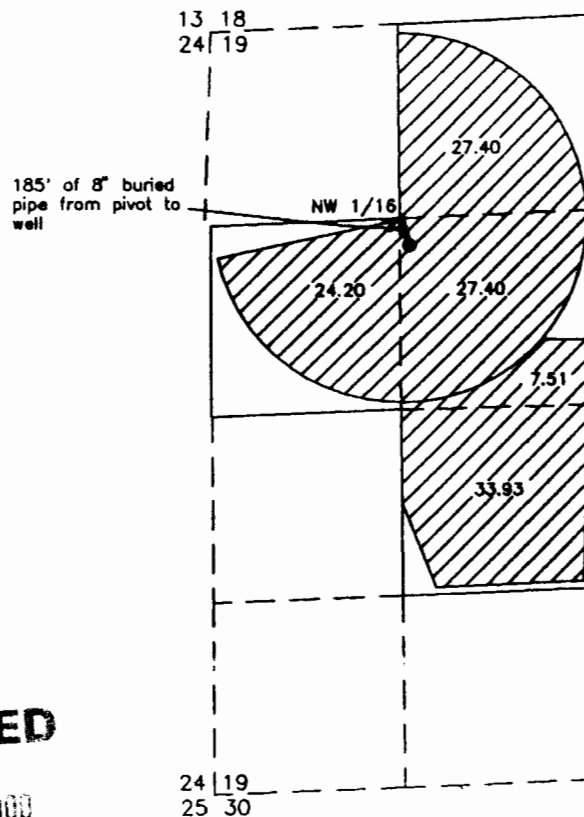


● Well is located S19°15'10"E
197.99' from the NW 1/16 corner.

RECEIVED

SEP 29 2000

WATER RESOURCES DEPT.
SALEM, OREGON

Survey by: Sundet & Associates
P.O. Box 1228
Lakeview, OR 97630
541-947-3293
September 2000 Dr #12500

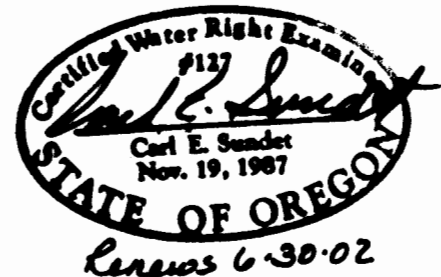

This map is for the purpose of identifying the location of the
water right only and is not intended to provide legal dimensions
or property ownership lines