




T28 S. R. 11 W. W. Md.

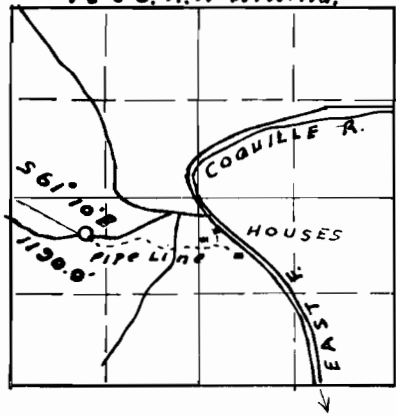

Map  
accompanying application of  
O. G. BUNCH  
to appropriate water.

I, J. N. Gearhart, of Myrtle Point, Oregon, do hereby certify that this map was made from notes taken during an actual survey made by me on Sept. 20, 1930, and that it correctly represents the works described in the accompanying application, together with the location of streams in the immediate vicinity.

J. N. Gearhart

J. N. Gearhart

13765  
9894