


# T.6S., R.1W., WM

MARION COUNTY

TAX LOTS:  
6 1W 29 01900  
6 1W 29 02000  
6 1W 30 01100  
6 1W 30 01200

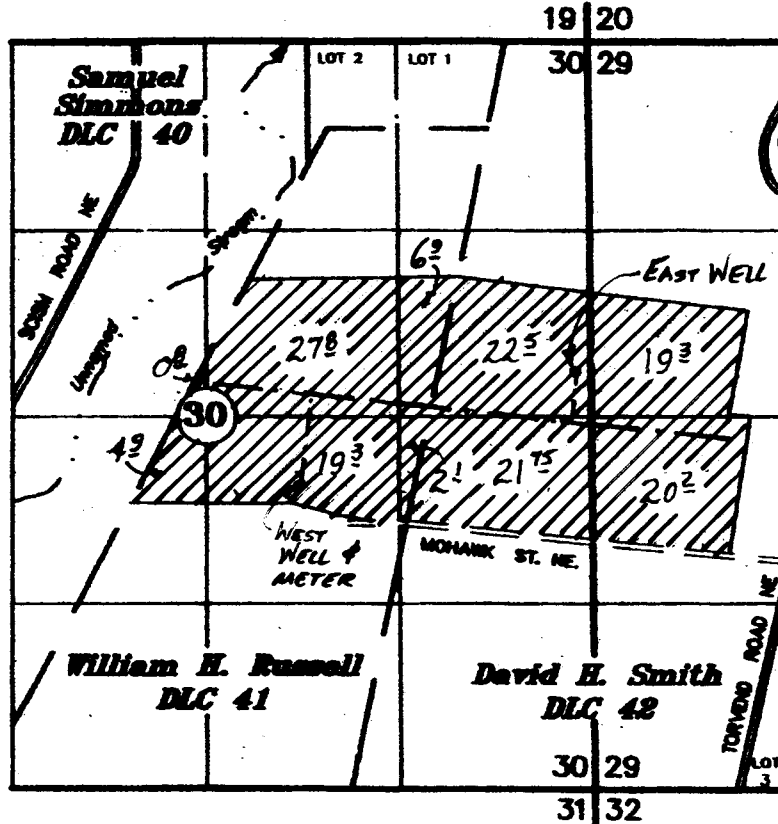

WEST WELL (NEW) - 2480' S AND 1280' W FROM THE NE CORNER OF Wm. RUSSELL DLC 41  
EAST WELL - 1710' S AND 600' E FROM THE NE CORNER OF Wm. RUSSELL DLC 41

RECEIVED

JUN 02 2000

WATER RESOURCES DEP  
SALEM, OREGON

## Claim of Beneficial Use Map


UNDER

Transfer T-10118

IN THE NAME OF

**EDER BROS., INC.**

SCALE: 1" = 1320'

 

NOTE: This map is not intended to provide legal dimensions or locations of property ownership lines.