


Marvin & Chloe Walker

Township 35 South, Range 12 East, W.M.

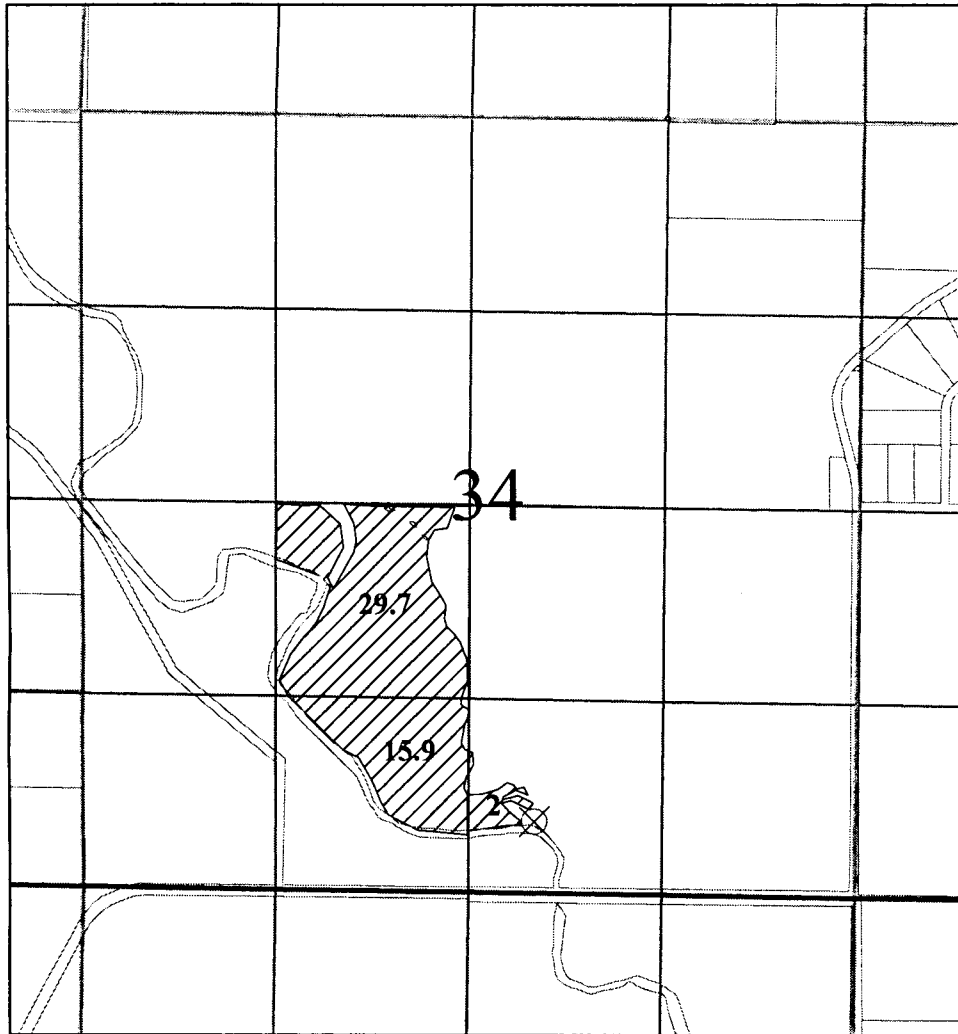

1 inch = 1,320 feet

Proposed Final Proof
Application 63521 Permit 46826

POD: 530 Feet North and 2110 Feet West from the SE Corner of Section 34

January 2015