


Application No. **R-83917**
 Permit No. **W12686**

RECEIVED
 AUG 17 1998
 WATER RESOURCES DEPT.
 SALEM, OREGON

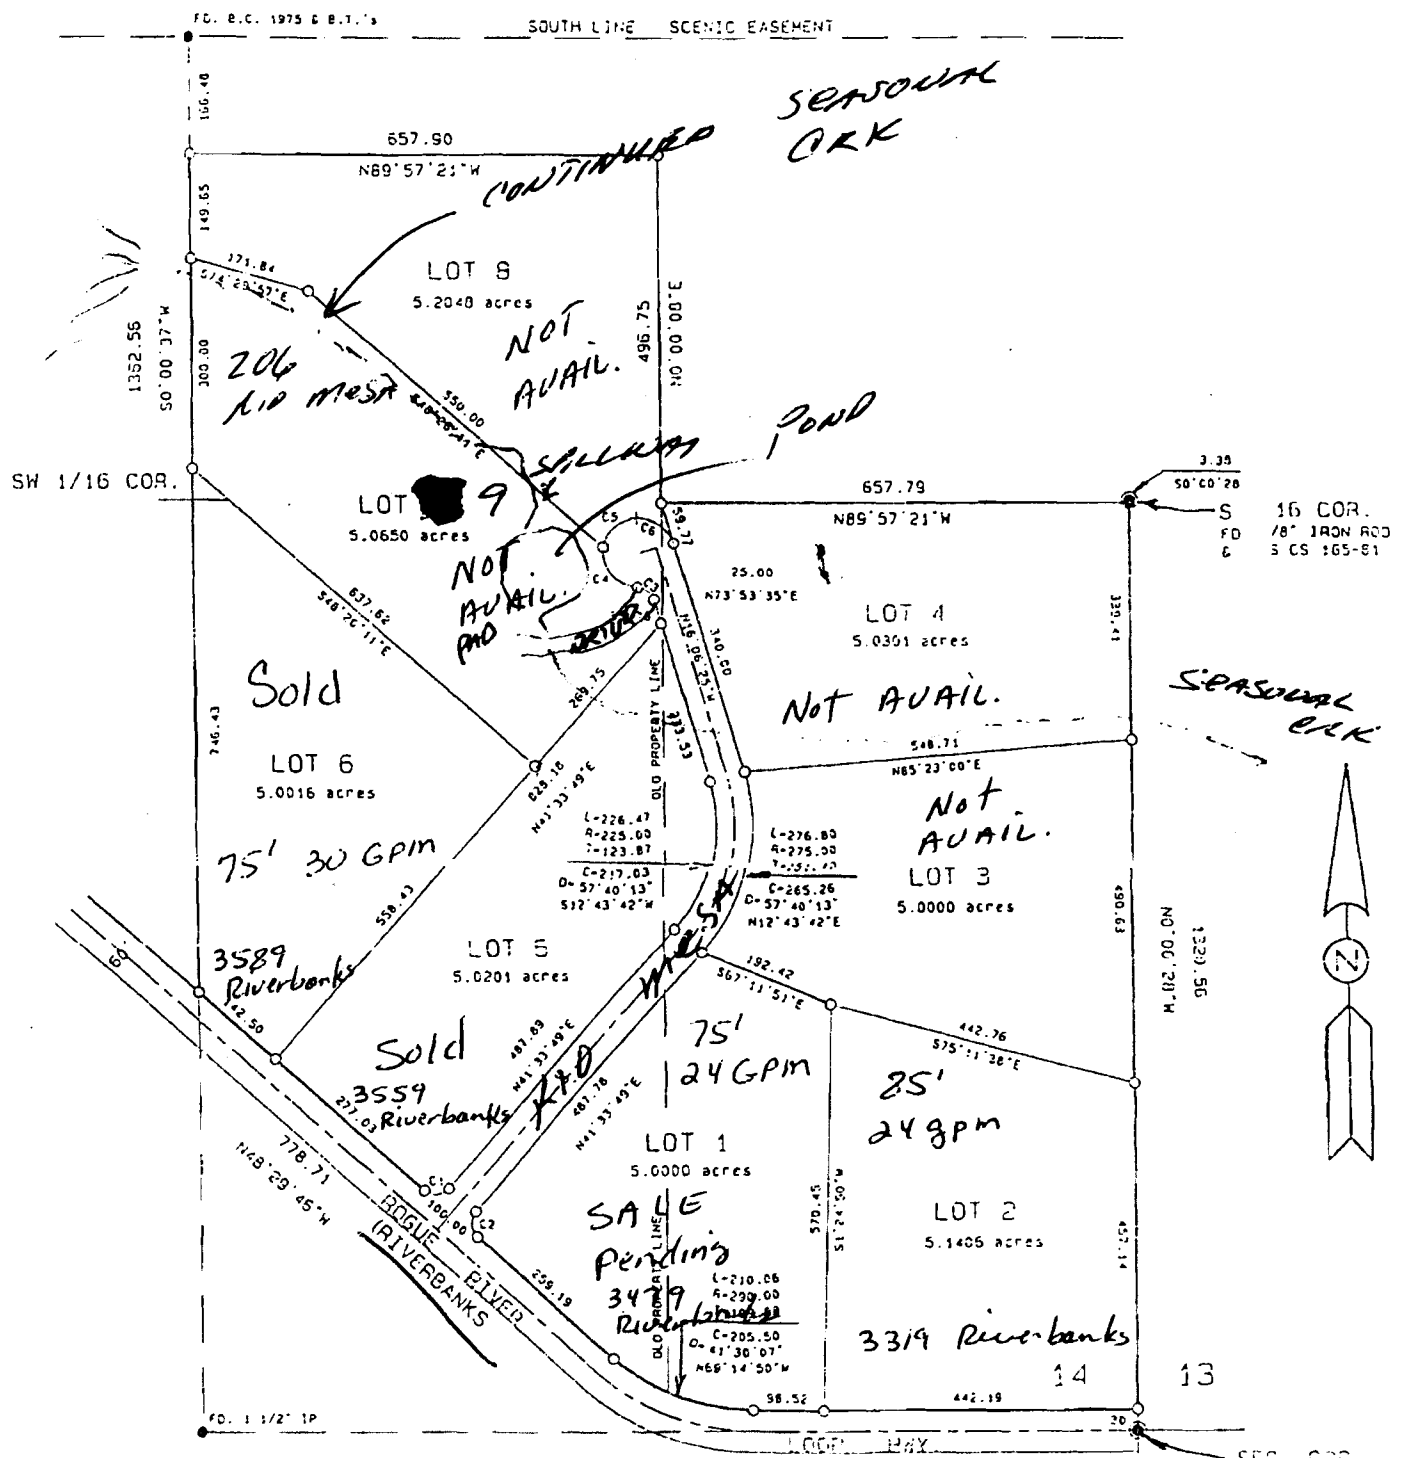

Well Info & Addressed

RECEIVED BY OWRD

AUG 13 2014

SALEM, OR