

THIS MAP WAS ASSESSMENT I

This sketch is provided, without charge, for your information. It is not intended to show all matters related to the property including, but not limited to, area, dimensions, easements, encroachments, or location of boundaries. It is not a part of, nor does it modify, the commitment or policy to which it is attached. The Company assumes no liability for any matter related to this sketch. Reference should be made to an accurate survey for further information.

SECTION 3  
LINCOLN

Order Number: 122132 Scale: 1" = 400'  
County Assessor's Map 7-11-36 PTV TL 600

Application No. R83874  
Permit No. R-12674

RECEIVED

N↑


JUN 24 1998

WATER RESOURCES DEPT.  
SALEM, OREGON

RECEIVED BY OWRD

MAY 23 2014

SALEM, OR

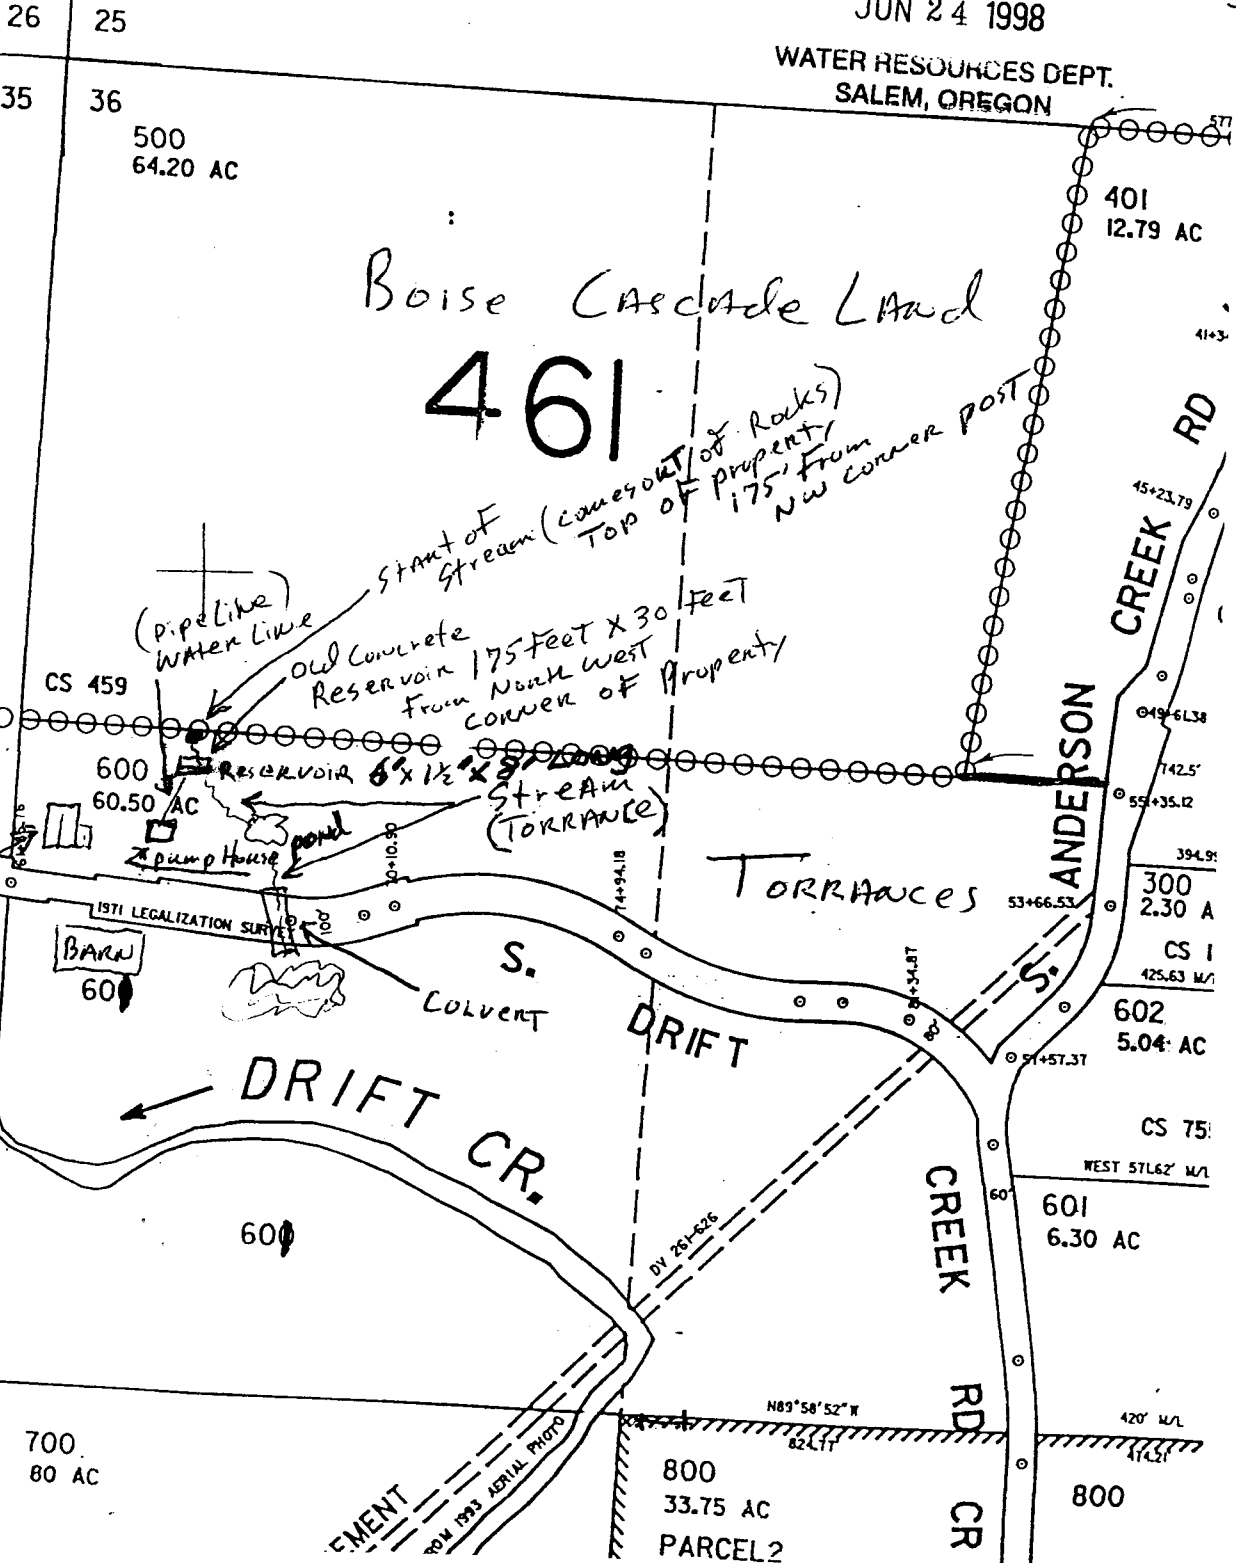

property →

House

BARN 60

DRIFT CR.

S. COLUVENT

TORRANCES

S. ANDERSON

CREEK RD

EE MAP 07 11 35

CS5027

700  
80 AC

800  
33.75 AC  
PARCEL 2

800

601  
6.30 AC

602  
5.04 AC

300  
2.30 A  
CS 1  
425.63 M/L

742.5'  
55+35.12

45+23.79

401  
12.79 AC

577

N89°58'52" W  
82.11'

DV 281-226

60'


















26

25

35

36

500  
64.20 AC

CS 459

600  
60.50 AC

1971 LEGALIZATION SURVEY

Stream (TORRANCES)

Old Concrete Reservoir 175 Feet X 30 Feet From North West Corner of Property

Start of Stream (comes out of Rocks) 175' From Top of Property

Boise Cascade Land  
461

41+3'

577

577

