

This sketch is provided, without charge, for your information. It is not intended to show all matters related to the property including, but not limited to, area, dimensions, easements, encroachments, or location of boundaries. It is not a part of, nor does it modify, the commitment or policy to which it is attached. The Company assumes no liability for any matter related to this sketch. Reference should be made to an accurate survey for further information.

SECTION 36
LINCOLN

THIS MAP WAS
ASSESSMENT 1

Order Number: 122132 Scale 1" = 400'
County Assessor's Map 7-11-36 PTN TL 600

Application No. R83874 R84035
Permit No. R-12675


RECEIVED

N↑

JUN 24 1998

SEE

WATER RESOURCES DEPT.
SALEM, OREGON

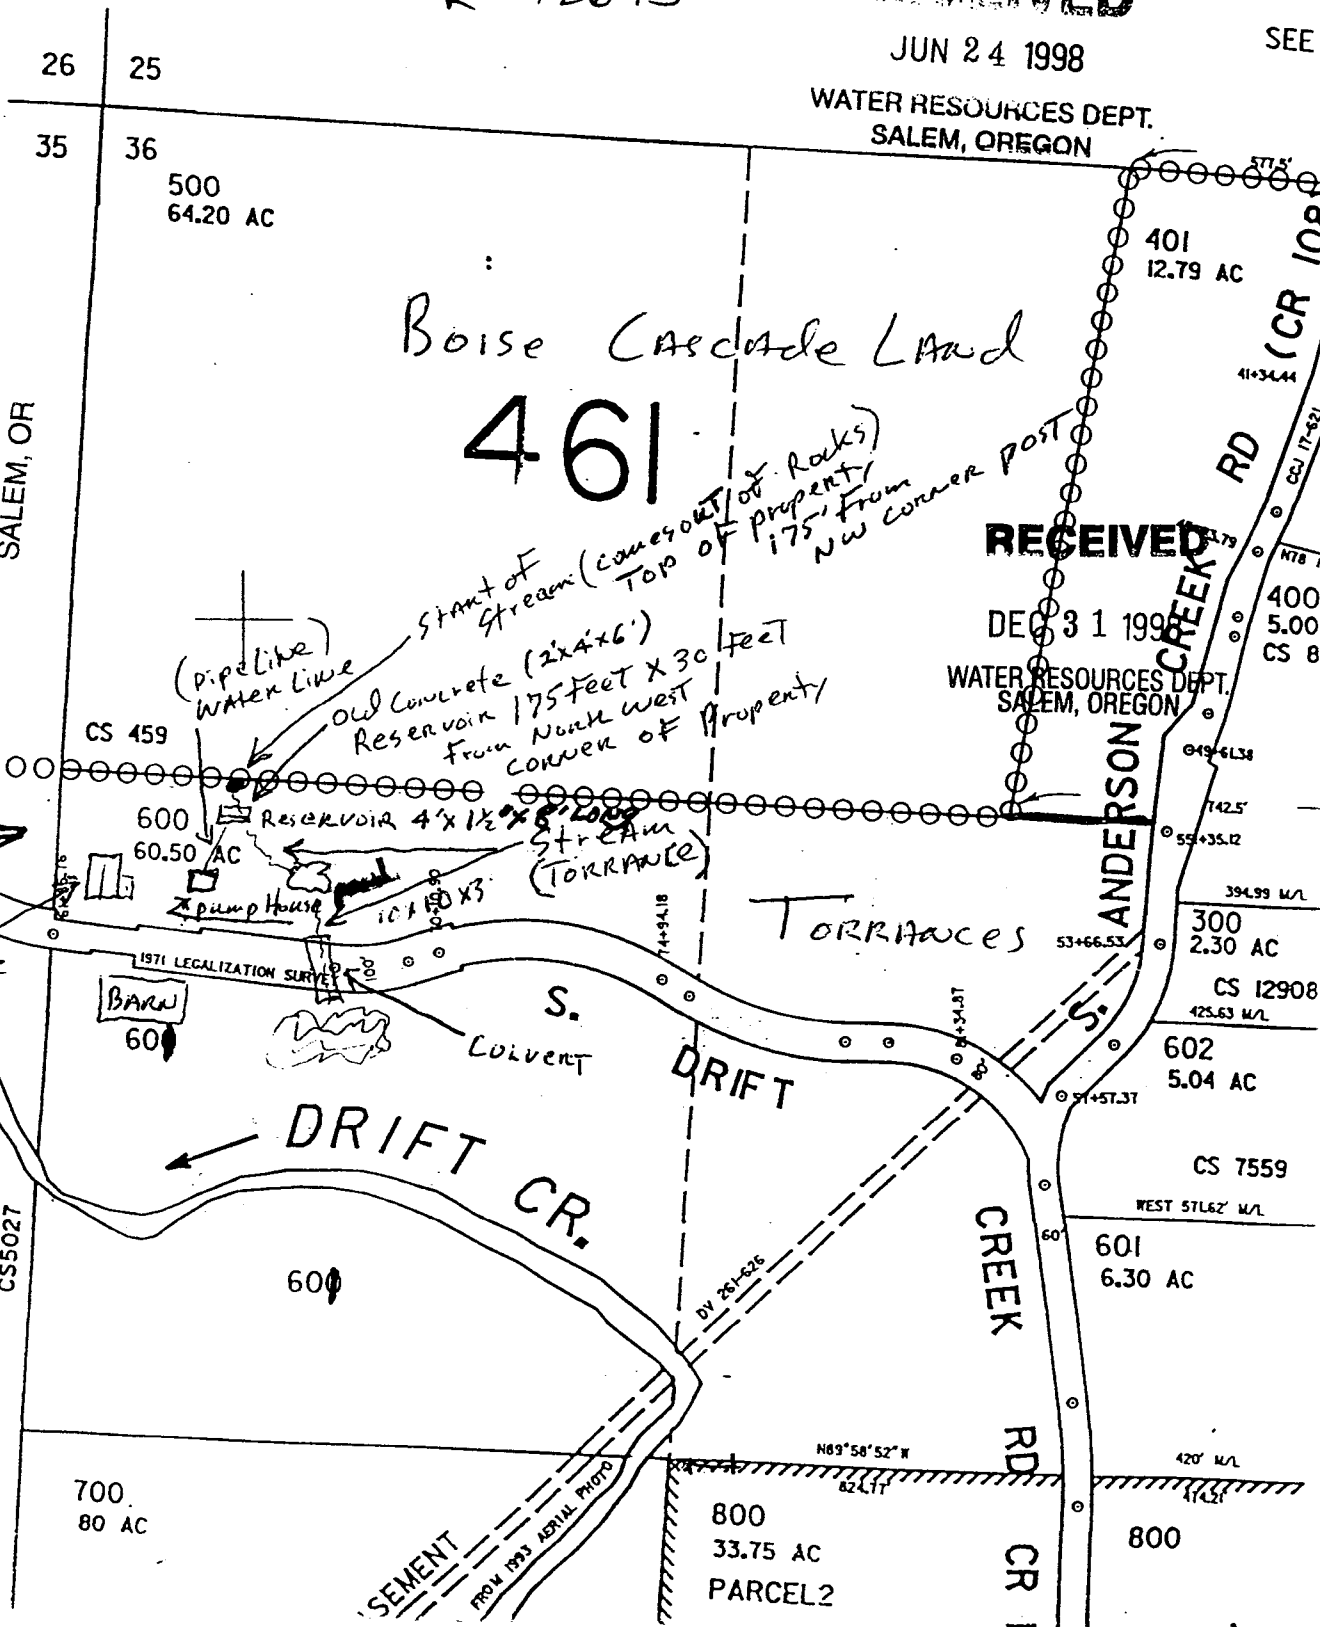

RECEIVED BY OWRD

MAY 28 2014

SALEM, OR

property →

House

BARN

S. COUVENT

DRIFT

DRIFT CR.

CREEK

RD CR 1

RECEIVED

DEC 31 1998

WATER RESOURCES DEPT.
SALEM, OREGON

SEE MAP 07 11 35

700
80 AC

800
33.75 AC
PARCEL 2

800