


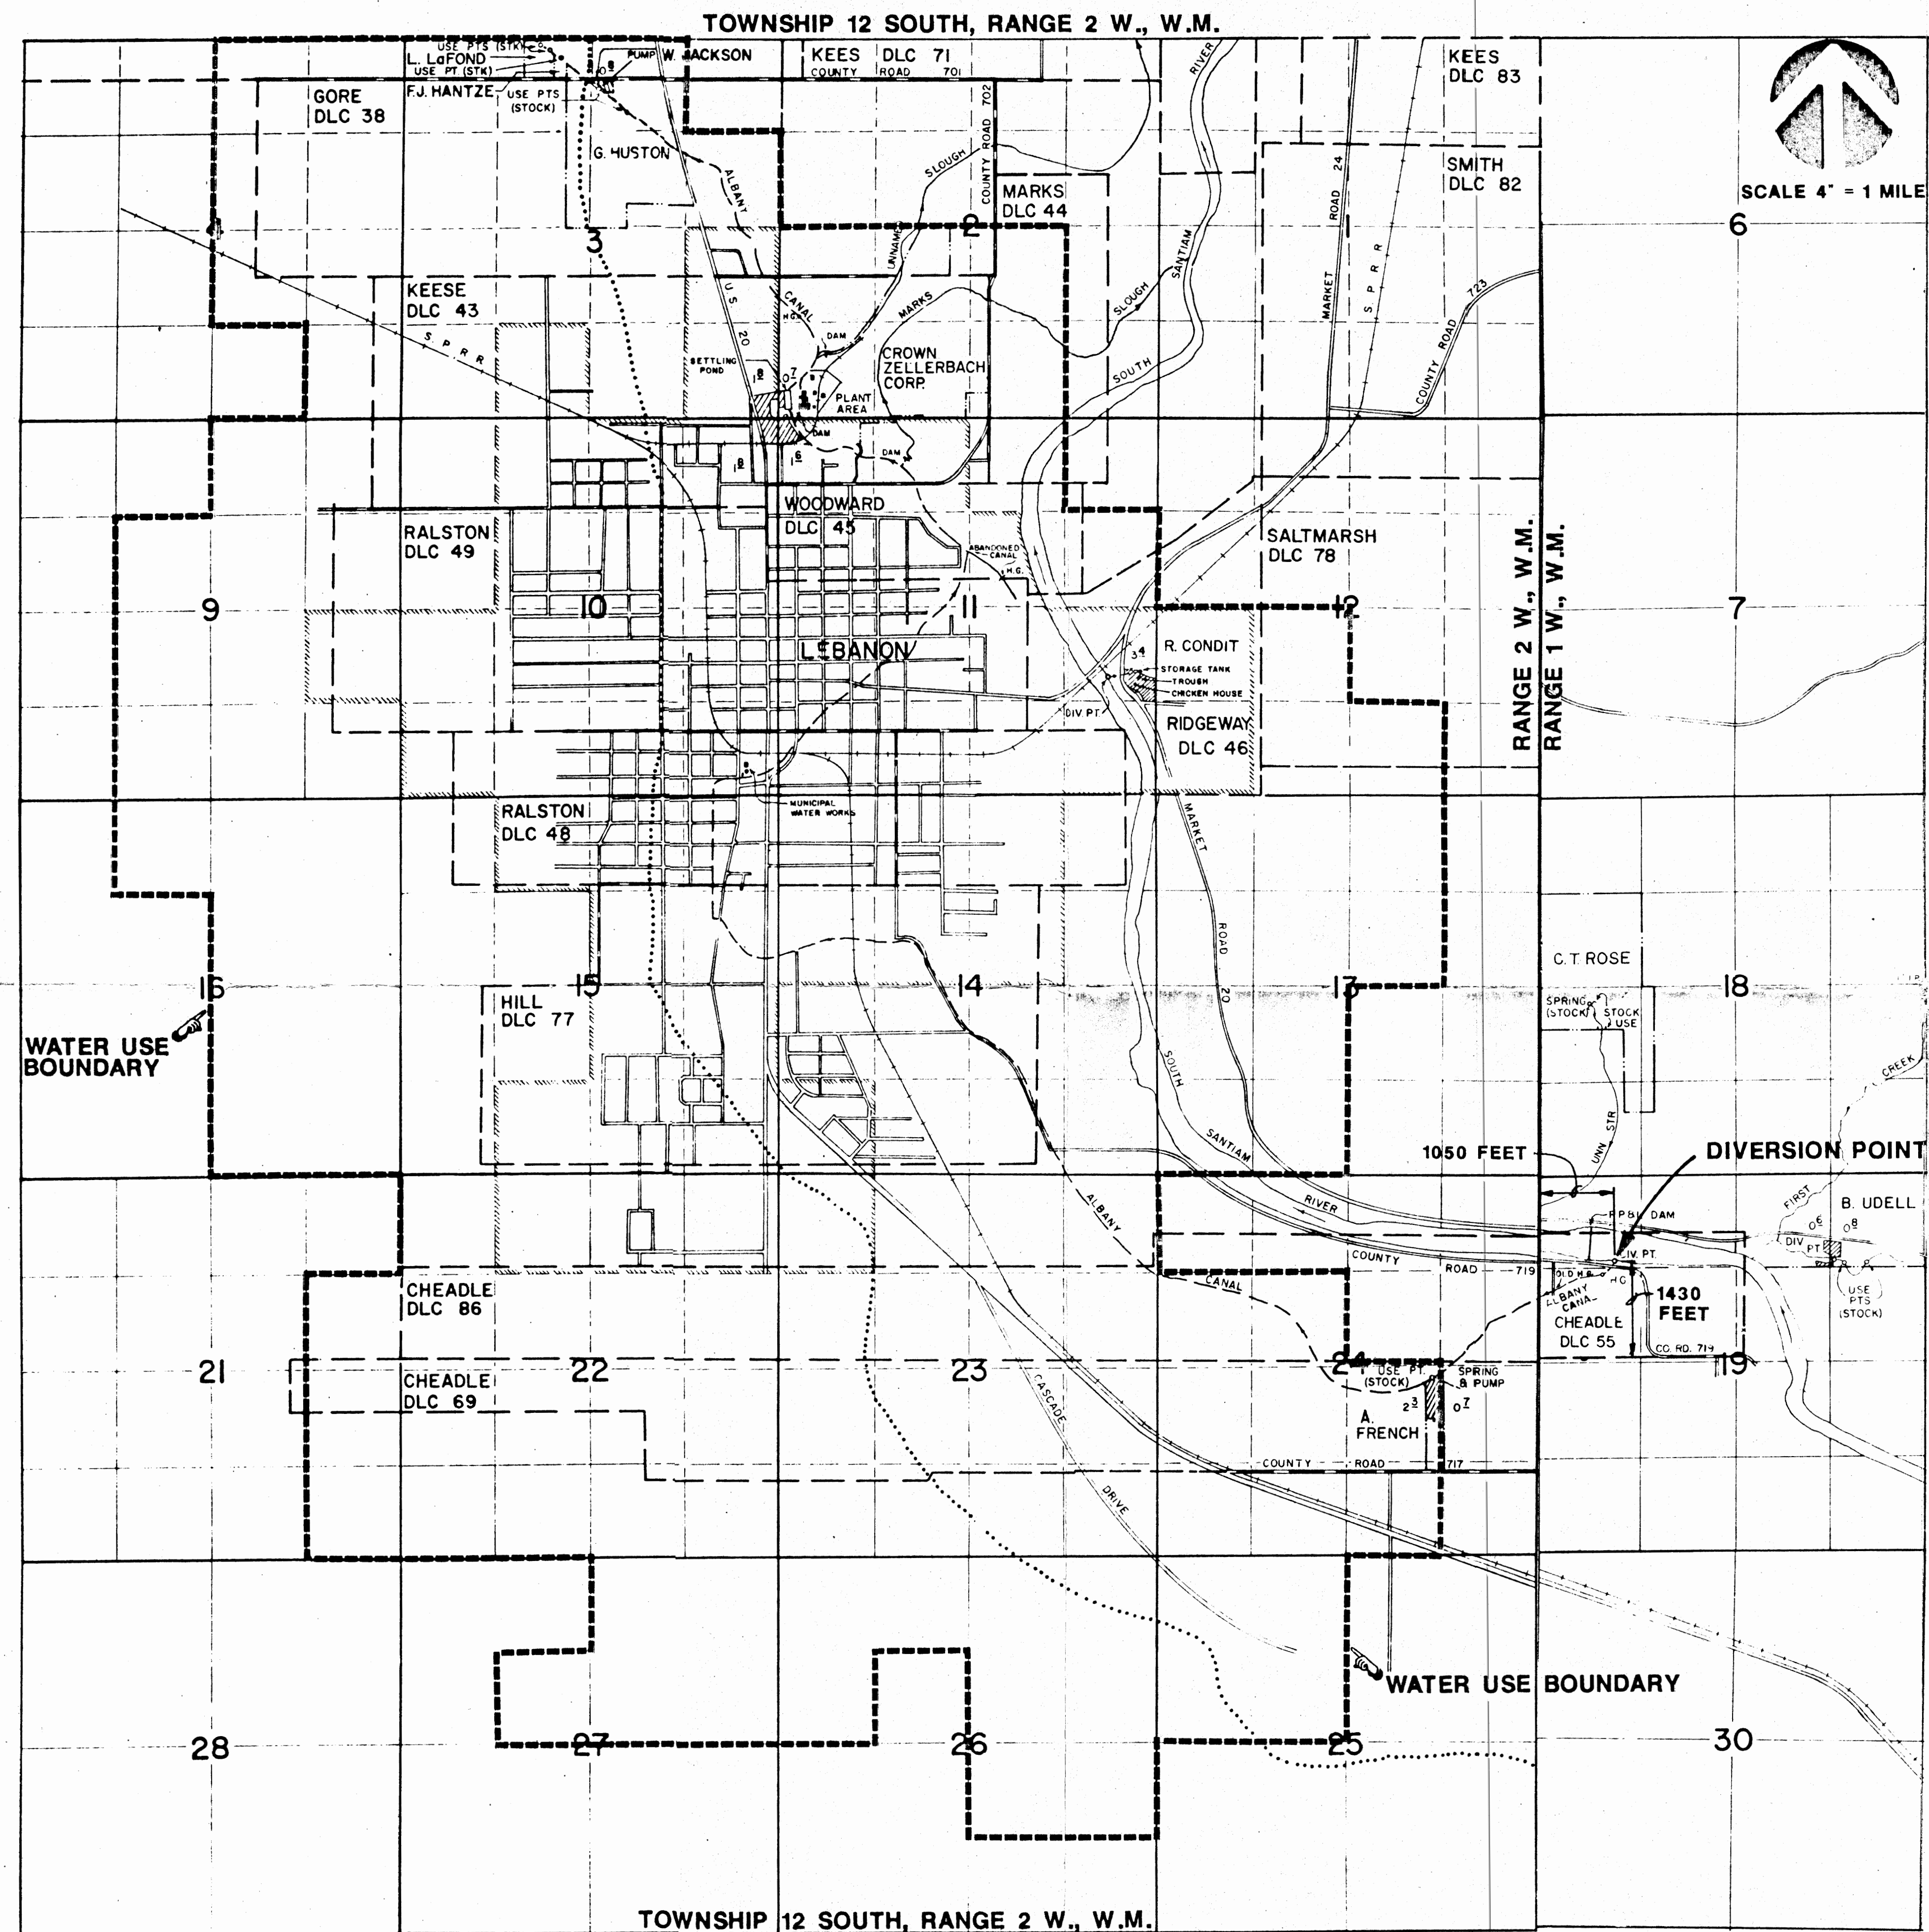

APPLICANT:


City of Lebanon
925 Main Street
Lebanon, Oregon 97355

RECEIVED

APR 28 1997

WATER RESOURCES DEPT.
SALEM, OREGON

NOTE:
THIS MAP IS FOR THE PURPOSE OF IDENTIFYING
AREA OF USE FOR A WATER RIGHT AND HAS NO
INTENTION TO DIMENTION OR LOCATE PROPERTY
OWNERSHIP.

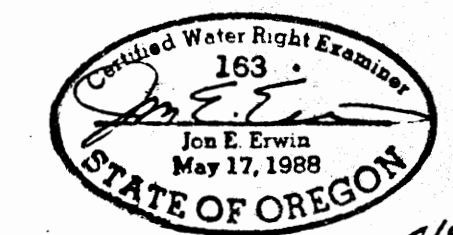

WATER RIGHT TRANSFER
FINAL PROOF MAP

T. 12 S., R. 2 W., W.M.
SECTIONS 2,3,4,9,10,11,12,13,14,15,16,
21,22,23,24,25,26,27