


TOWNSHIP 13 SOUTH, RANGE 9 EAST, W.M.

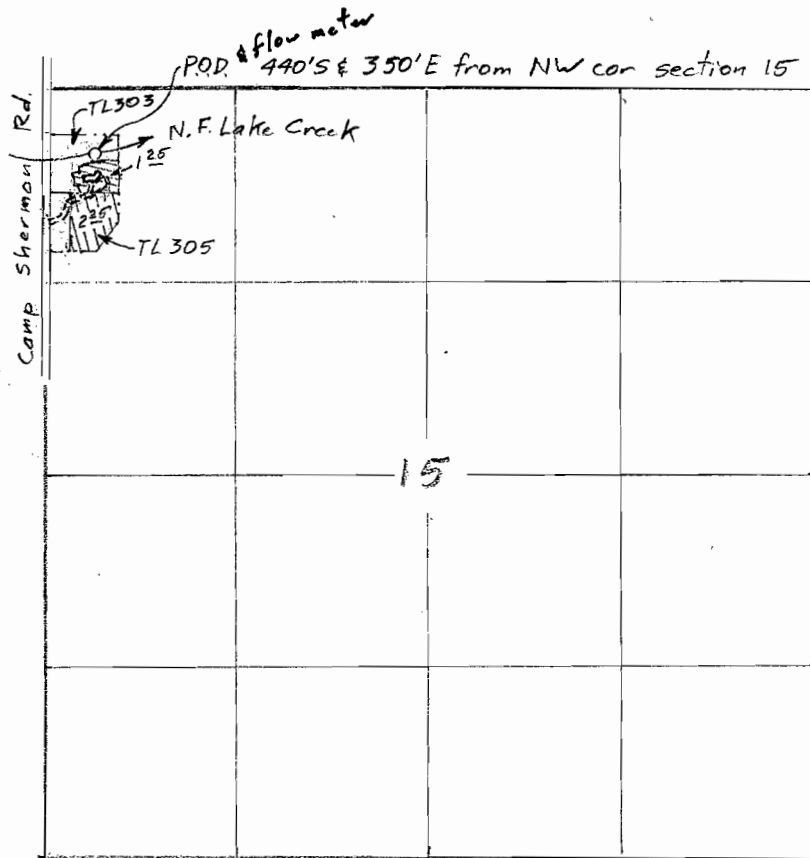


Surveyed Sep 15, 2007

T- 9807

- ⊗ To 125 ac
- ⊗ C-81669 (Remaining Right)

Claim of Beneficial Use Map
for
DAVID A. RICHENSTEIN

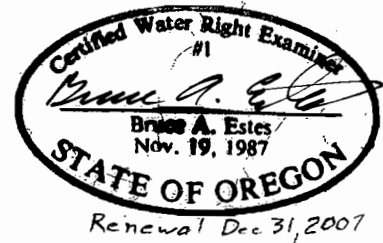

RECEIVED
SEP 20 2007
WATER RESOURCES DEPT
SALEM, OREGON

This map is for the purpose of locating a water right only and has no intent to provide legal dimensions or the location of property lines.

ESTES SURVEYS, LLC
PO Box 17519 Salem, OR 97306-7519 (503) 585-7593
60382 Arnold Rd Bend, OR 97702 (541) 382-7391