


T.37S.,R.3E.,W.M.

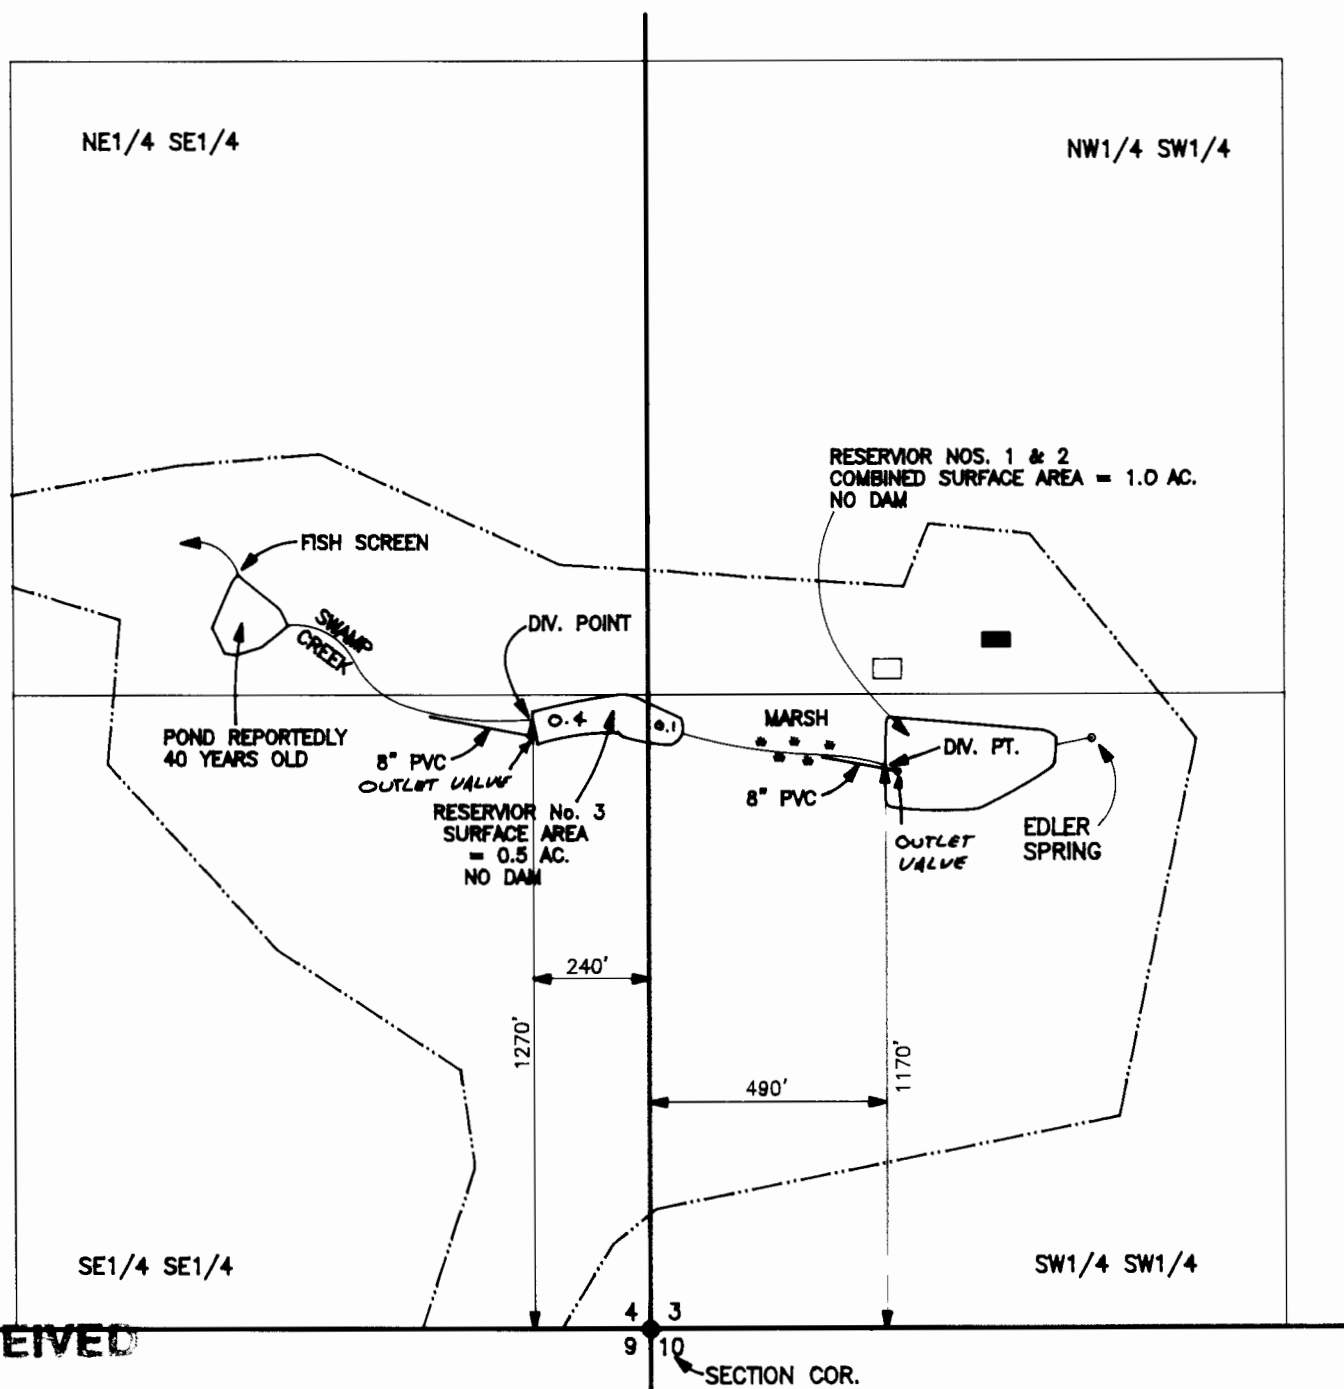


RECEIVED

SEP 26 2000

WATER RESOURCES DEPT
SALEM, OREGON

FINAL PROOF MAP ✓
APPLICATION No. R-74404

IN THE NAME OF
CHARLES G. WILSON

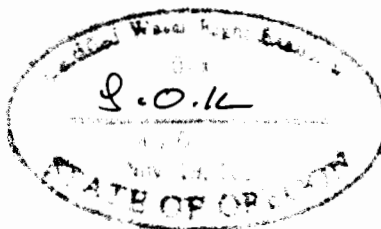

NOTE: MAP PREPARED FOR
WATER RIGHT PURPOSES ONLY,
NOT FOR PROPERTY BOUNDARY
LOCATIONS.



SCALE 1" = 400'

MAP PREPARED SEPTEMBER 13, 2000 BY GARY D. KAISER