


SECTION 19 & 20, T.3S., R.3W., W.M.

YAMHILL COUNTY, OREGON

18 17
19 20

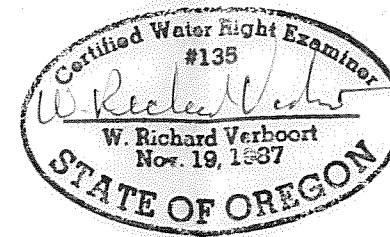

NW COR
JAMES SCOTT
DLC ~~30~~
50

KKK
OWRD
1-14-15

N

SCALE: 1"=400'

MAP BASE:
ASSESSORS MAP
06-28-02 SCALED PHOTO

HENDRICKS RD.

KUEHNE RD.

OAK SPRINGS FARM RD.

ABBY RD.

INTERVALE RD.

825'

1460'

T.L. 100

RESERVOIR

T.L. 201

NOTE:
IRRIGATED AREA
NOT DEVELOPED

T.L. 200

RECEIVED

MAR 05 2004

WATER RESOURCES DEPT
SALEM, OREGON

FINAL PROOF SURVEY

UNDER

APPLICATIONS PERMITS

S-77475

52410

R-77474

R-11837

SURVEYED FEBRUARY 19, 2004

PREPERATION OF THIS MAP IS FOR THE
PURPOSE OF IDENTIFYING THE LOCATION OF
THE WATER RIGHT ONLY. THERE IS NO INTENT
TO PROVIDE DIMENSIONS OR LOCATION OF
PROPERTY OWNERSHIP LINES.

JAMES H. STONEBRIDGE

620 E. 19th STREET
MCMINNVILLE, OR 97128

date	02/20/04
by	WRV JPR
designed	WRV
drawn	JPR
checked	WRV
drawing no.	04-B-03
sheet no.	1 / 1

VERBOORT ENGINEERING

AGRICULTURE · CIVIL · WATER RESOURCES

HILLSBORO, OREGON