


# CLAIM OF BENEFICIAL USE

Application No. R-81010/Permit No. R-12291  
& Application No. S-81602/Permit No. 53269



Owner: Sid Johnson  
3150 10th Street  
Baker City, OR 97814

Scale 1" = 1320'

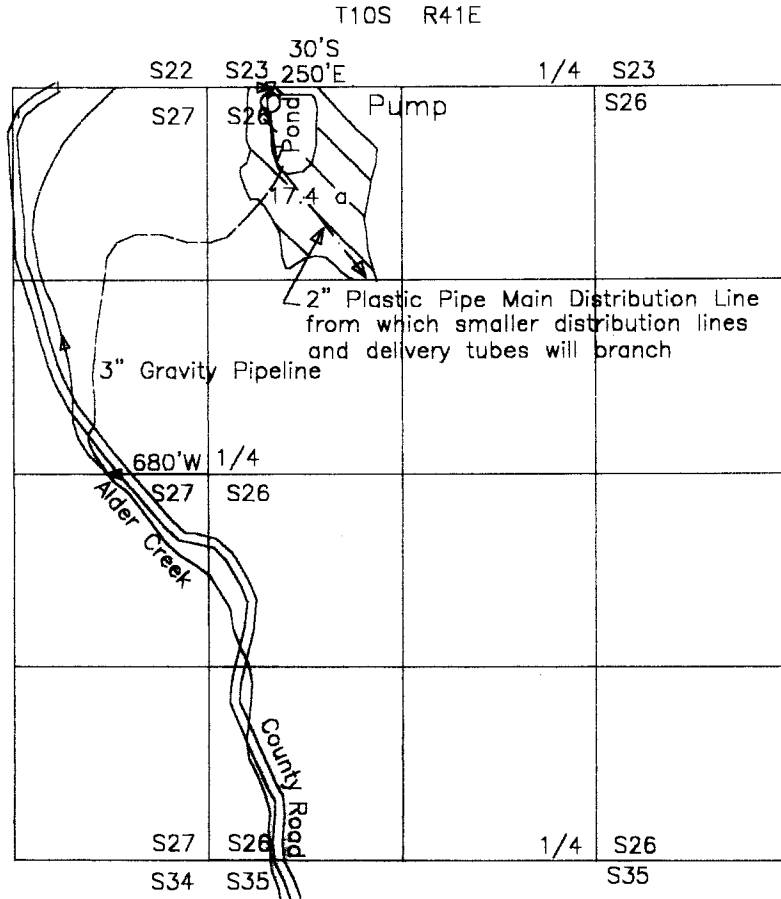

This map is for the purpose of identifying the location of the water right only and has no intent to provide dimensions or location of property ownership lines.