


SALEM, OR

SEE MAP 25 6 28

SE COR.
CALEB GROVE
DLC NO. 43 —

Applicant No. R-83993
Permit No. R-12692

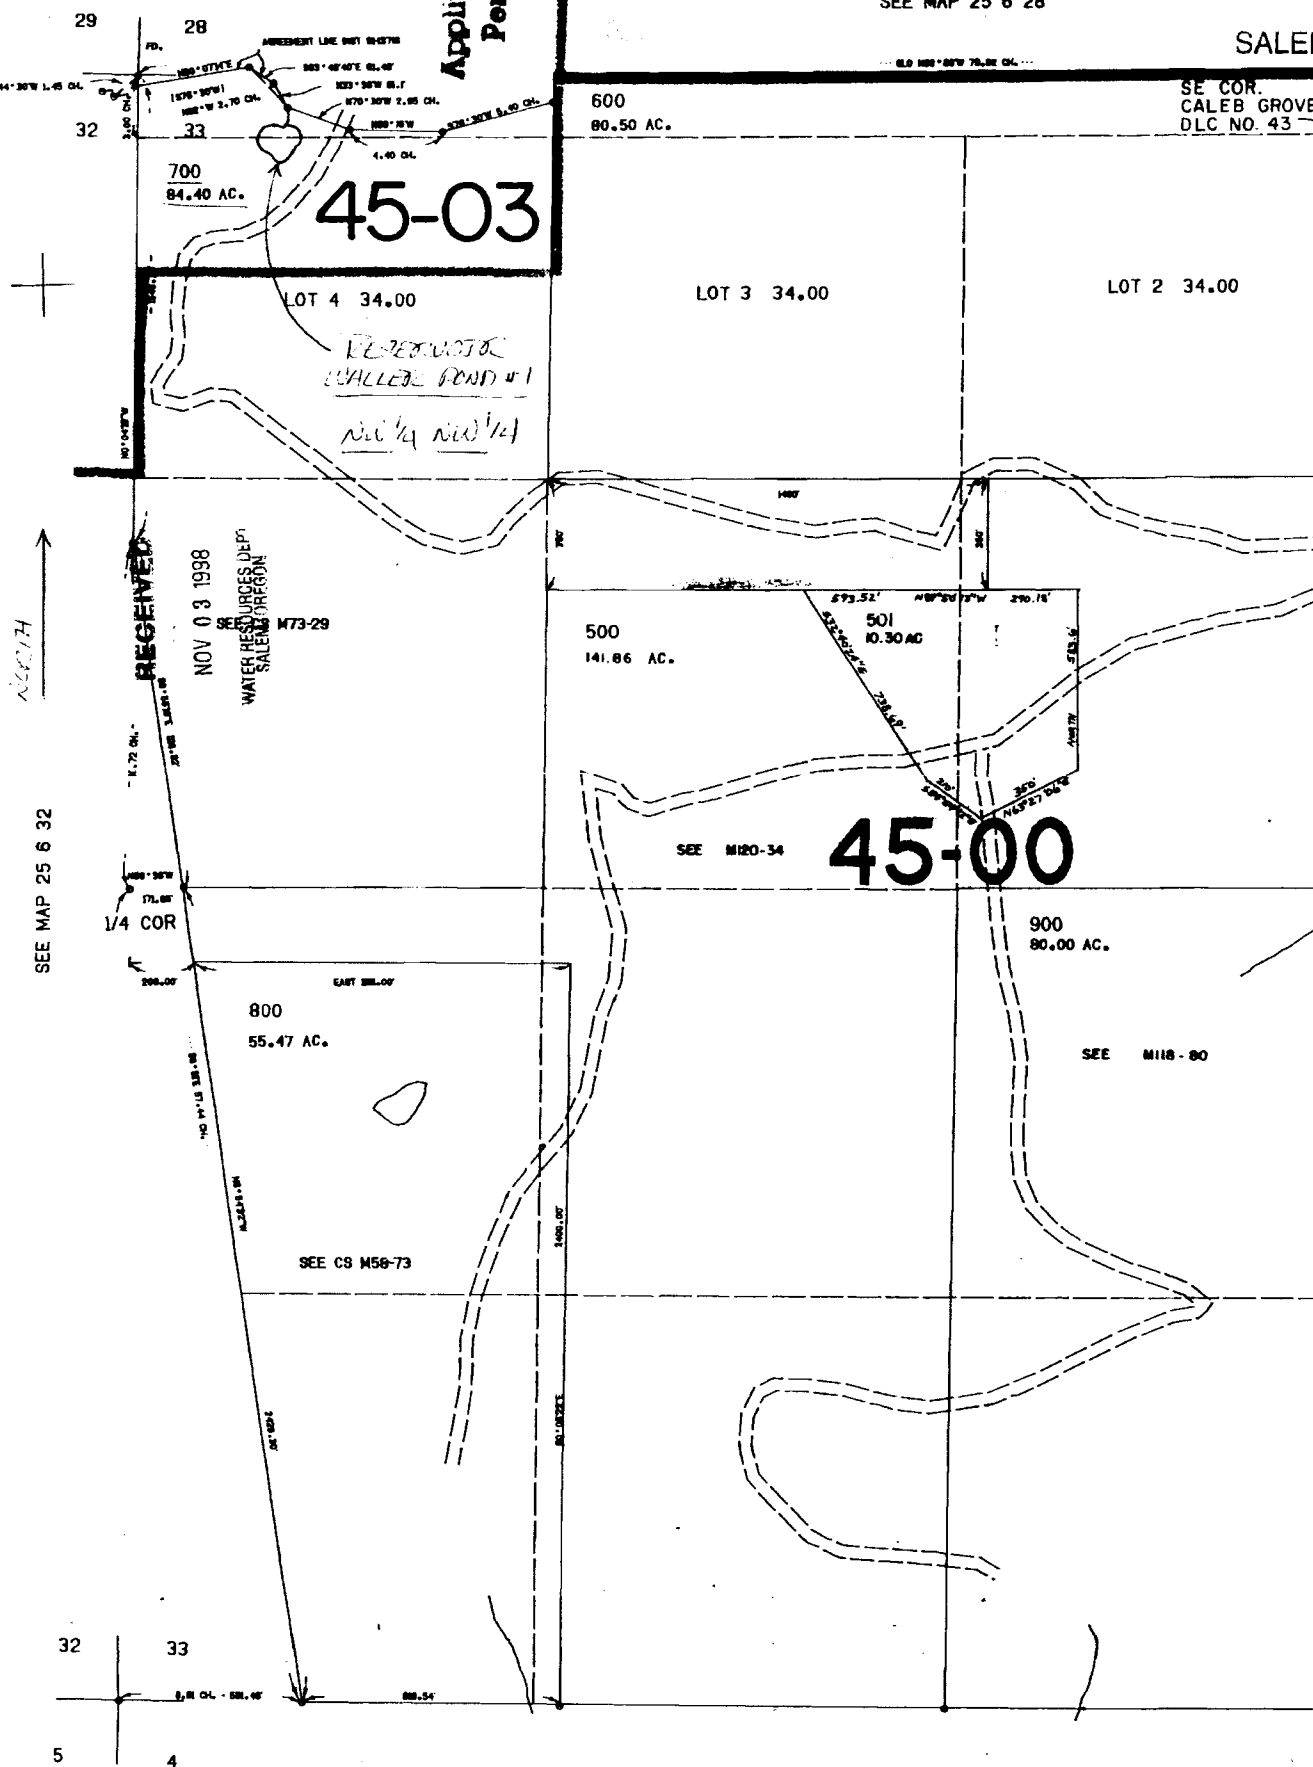

SEE MAP 26 6 4