SITE PLANNING MAP FOR MOUNTAIN FARMS, LLC

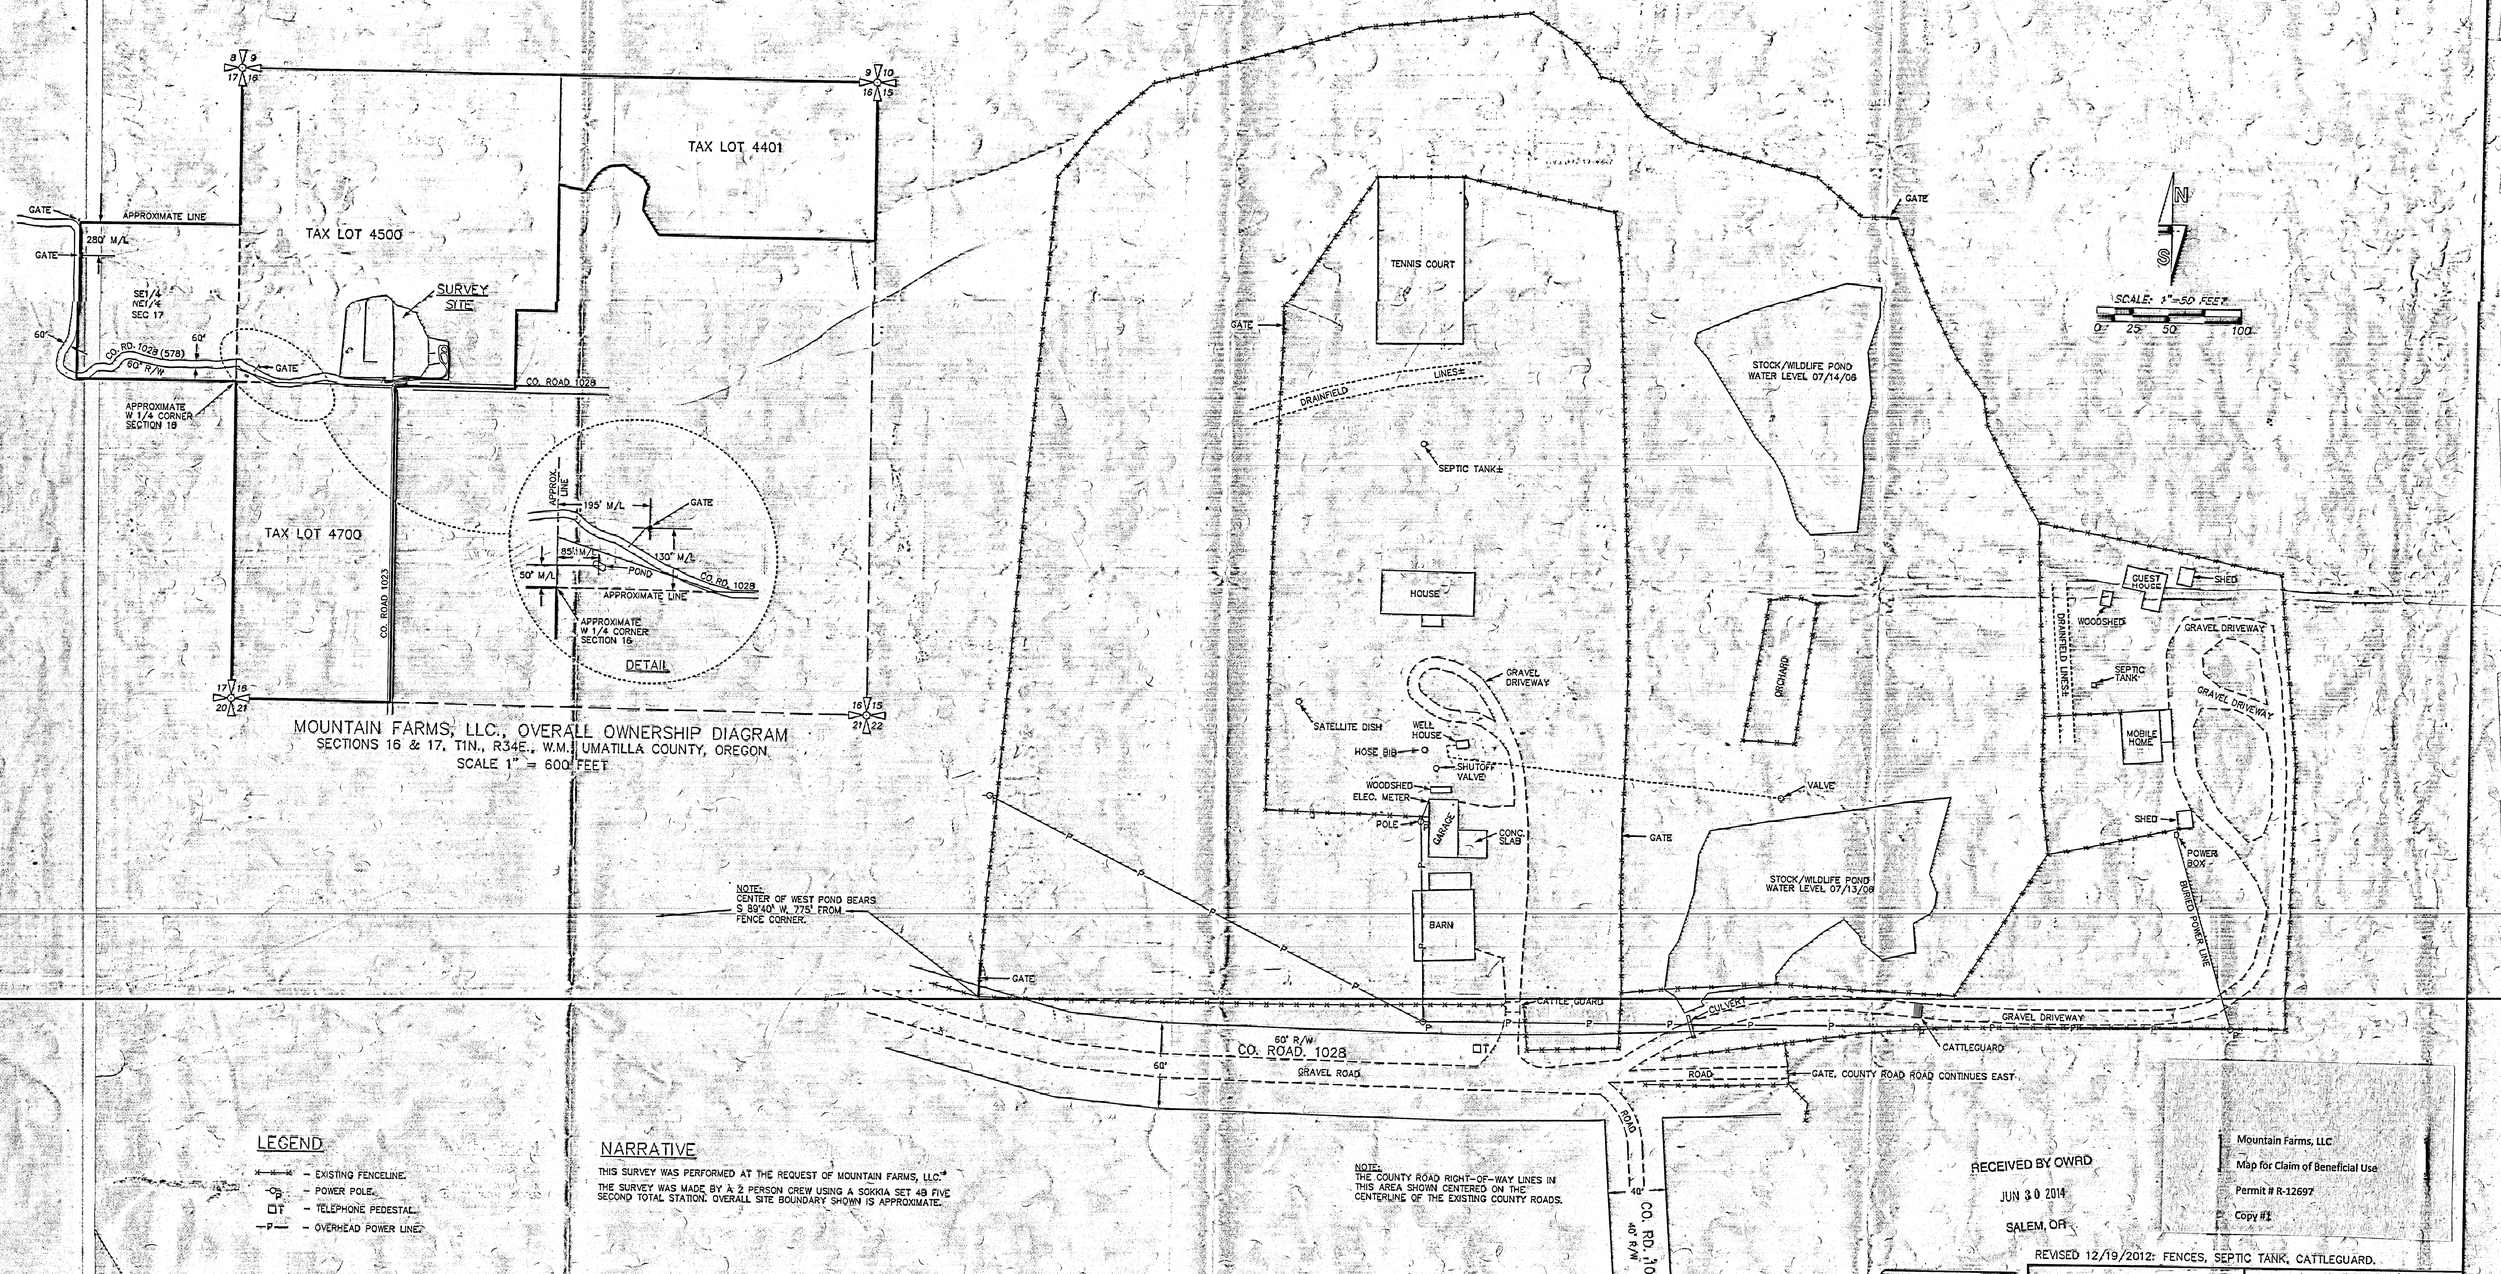

NOTE:
THE COUNTY ROAD RIGHT-OF-WAY LINES IN THIS AREA SHOWN CENTERED ON THE CENTERLINE OF THE EXISTING COUNTY ROADS.

LEGEND

- X—X—X — EXISTING FENCELINE.
- —O—P — POWER POLE.
- □T — TELEPHONE PEDESTAL.
- —P— — OVERHEAD POWER LINE.

NARRATIVE

THIS SURVEY WAS PERFORMED AT THE REQUEST OF MOUNTAIN FARMS, LLC.*

THE SURVEY WAS MADE BY A 2 PERSON CREW USING A SOKKIA SET 4B FIVE SECOND TOTAL STATION. OVERALL SITE BOUNDARY SHOWN IS APPROXIMATE.

RECEIVED BY OWRD
JUN 30 2014
SALEM, OR

Mountain Farms, LLC
Map for Claim of Beneficial Use
Permit # R-12697
Copy #1

REVISED 12/19/2012: FENCES, SEPTIC TANK, CATTLEGUARD.

REGISTERED PROFESSIONAL LAND SURVEYOR
Will R. Wells
OREGON JULY 22, 1972 WILLIAM R. WELLS 1108
RENEWS 6/30/14

WELLS SURVEYING
1 SW NYE AVENUE, SUITE B
P.O. BOX 1696
PENDLETON, OREGON
PHONE: (541) 276-6362

DATE: 7/08	DR. BY: JMW/DMT
CK. BY: WRW	NO: 08-1055

BETTYB2012

PROJECT:
SITE SURVEY FOR:
MOUNTAIN FARMS, LLC

LOCATED IN THE SECTIONS 16 AND 17, TOWNSHIP 1 NORTH, RANGE 34 EAST, W.M., UMATILLA COUNTY, OREGON.